HOLLYHOCK ROAD N.W.

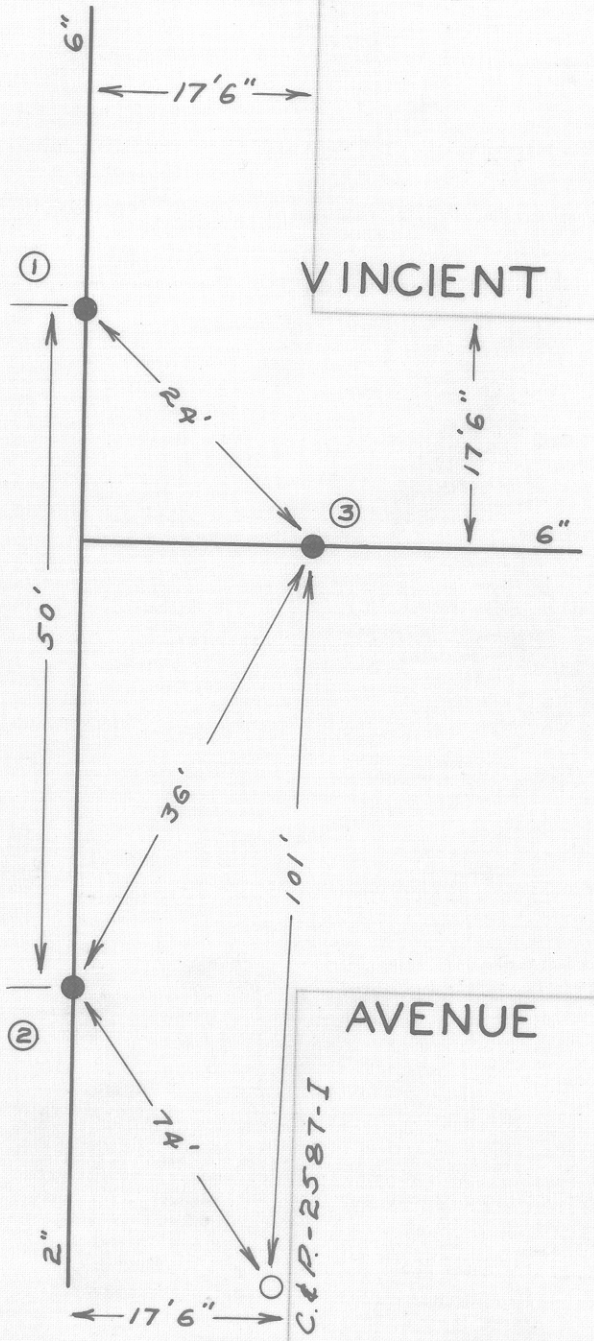

DATE	NO.	SIZE	MAKE	OPEN	TURNS
	1	6"	MUELLER	R	
	2	2"	DARLING	R	
	3	6"	MUELLER	R	
	1	0	NPL		
	2	0	SPL		
	3	0	EPL		

CITY OF ROANOKE—WATER DEP'T

VALVE DIAGRAM

HOLLYHOCK RD. &

VINCIENT AVE. N.W.

SEC. MAP 220

DATE PAGE NO.