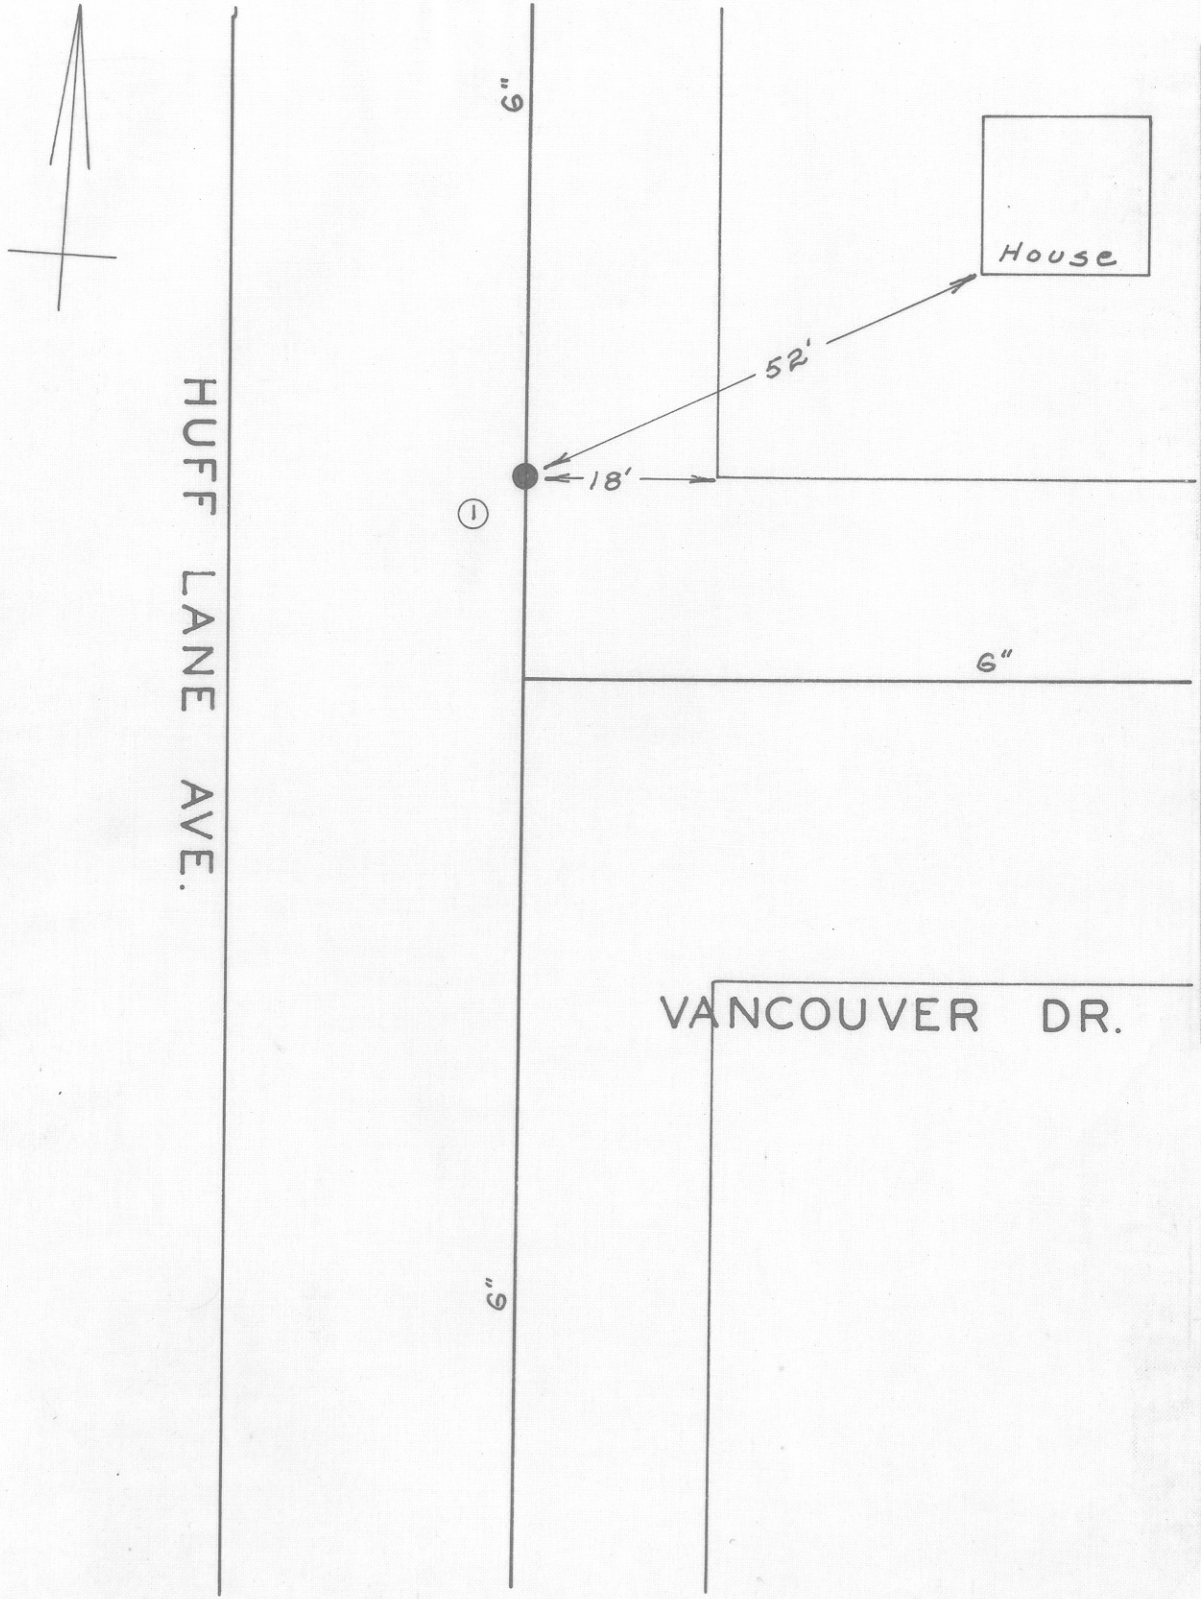

DATE	NO.	SIZE	MAKE	OPEN	TURNS
	1	6"	MUELLER	R	21
	1	0	NPL		

CITY OF ROANOKE—WATER DEPT.

VALVE DIAGRAM

HUFF LANE AVE. &
VANCOUVER DR. N.W.

SEC. MAP 226

DATE PAGE NO.

"IMPERIAL" TRACING CLOTH
K & E CO., N. Y.