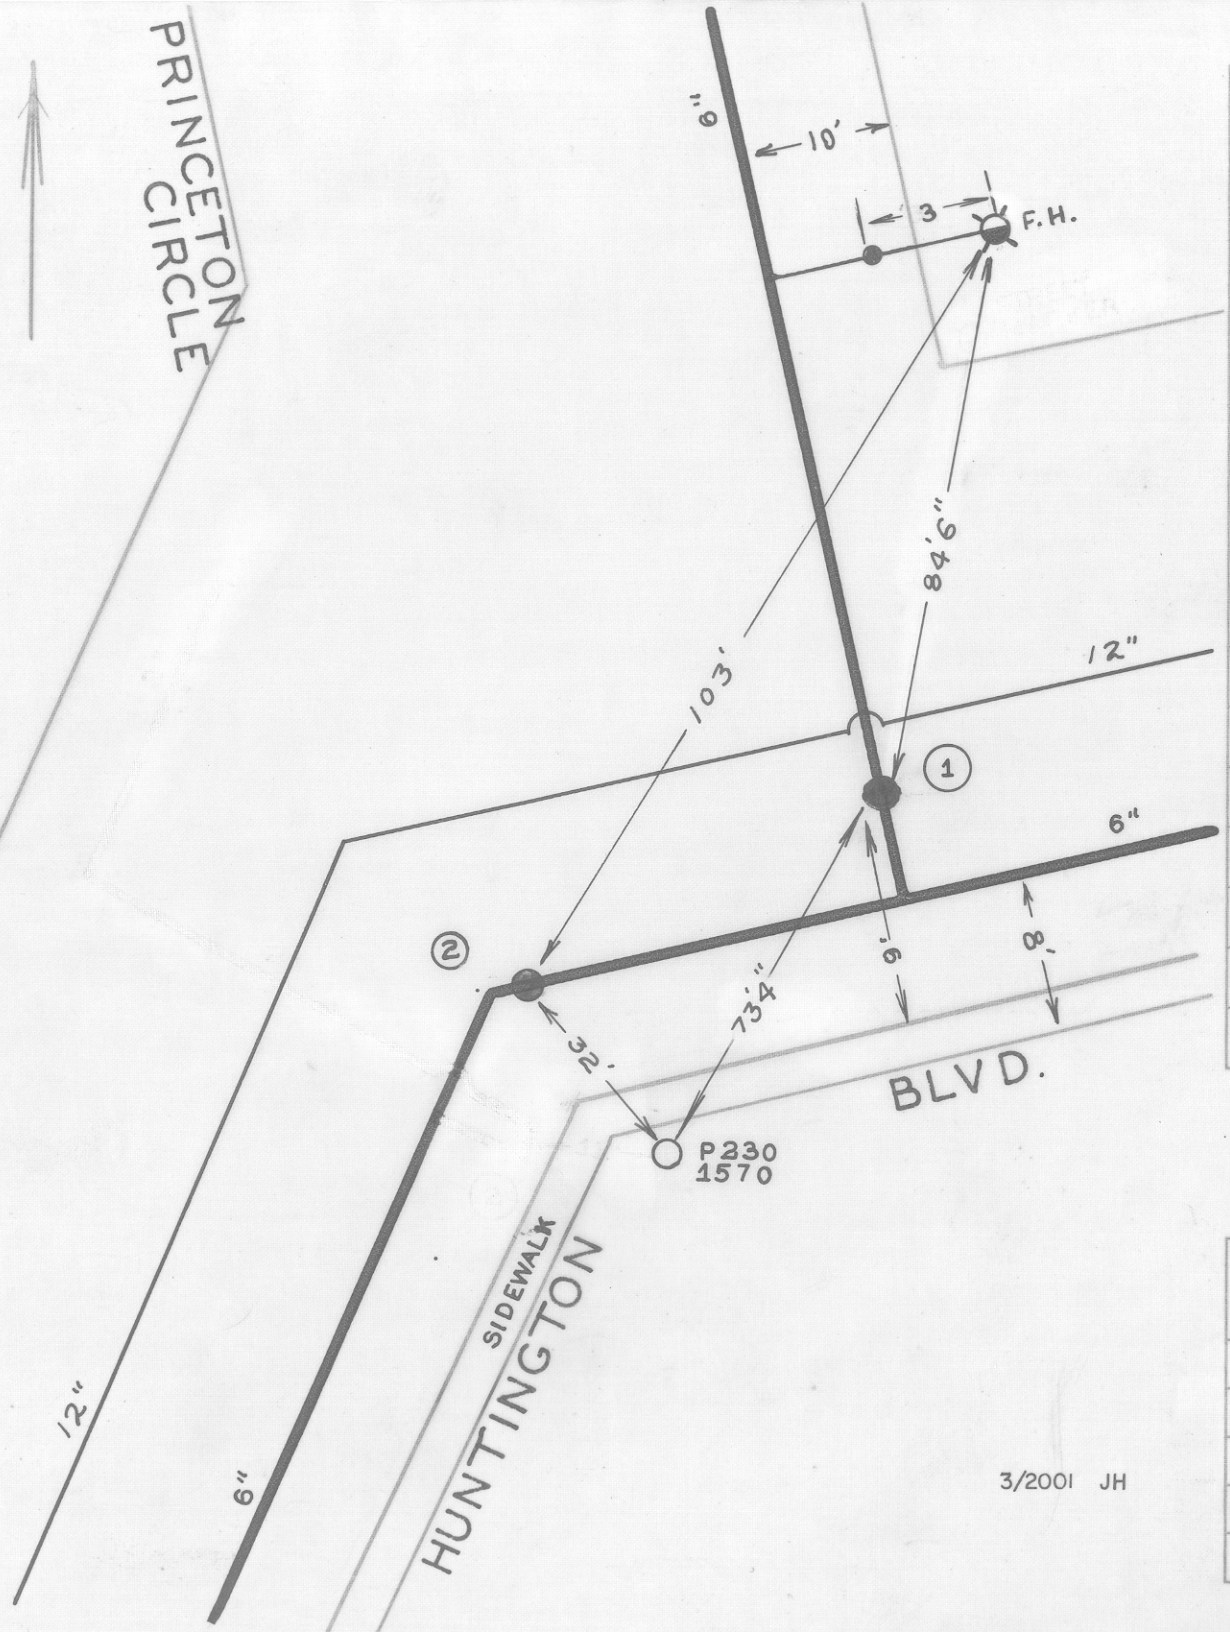

DATE	NO.	SIZE	MAKE	OPEN	TURNS
WR 1951	1	6"			
56	2	6"	MUELLER	R	
	1	31'-5	NPL		
	2	0	WPL		

CITY OF ROANOKE — WATER DEPT.

VALVE DIAGRAM

HUNTINGTON BOULEVARD & PRINCETON CIRCLE NORTH INTERSECTION

SEC. MAP 316, 317 N.E.

DATE WR PAGE NO. NE200

"IMPERIAL" TRACING CLOTH
K & E CO., N. Y.