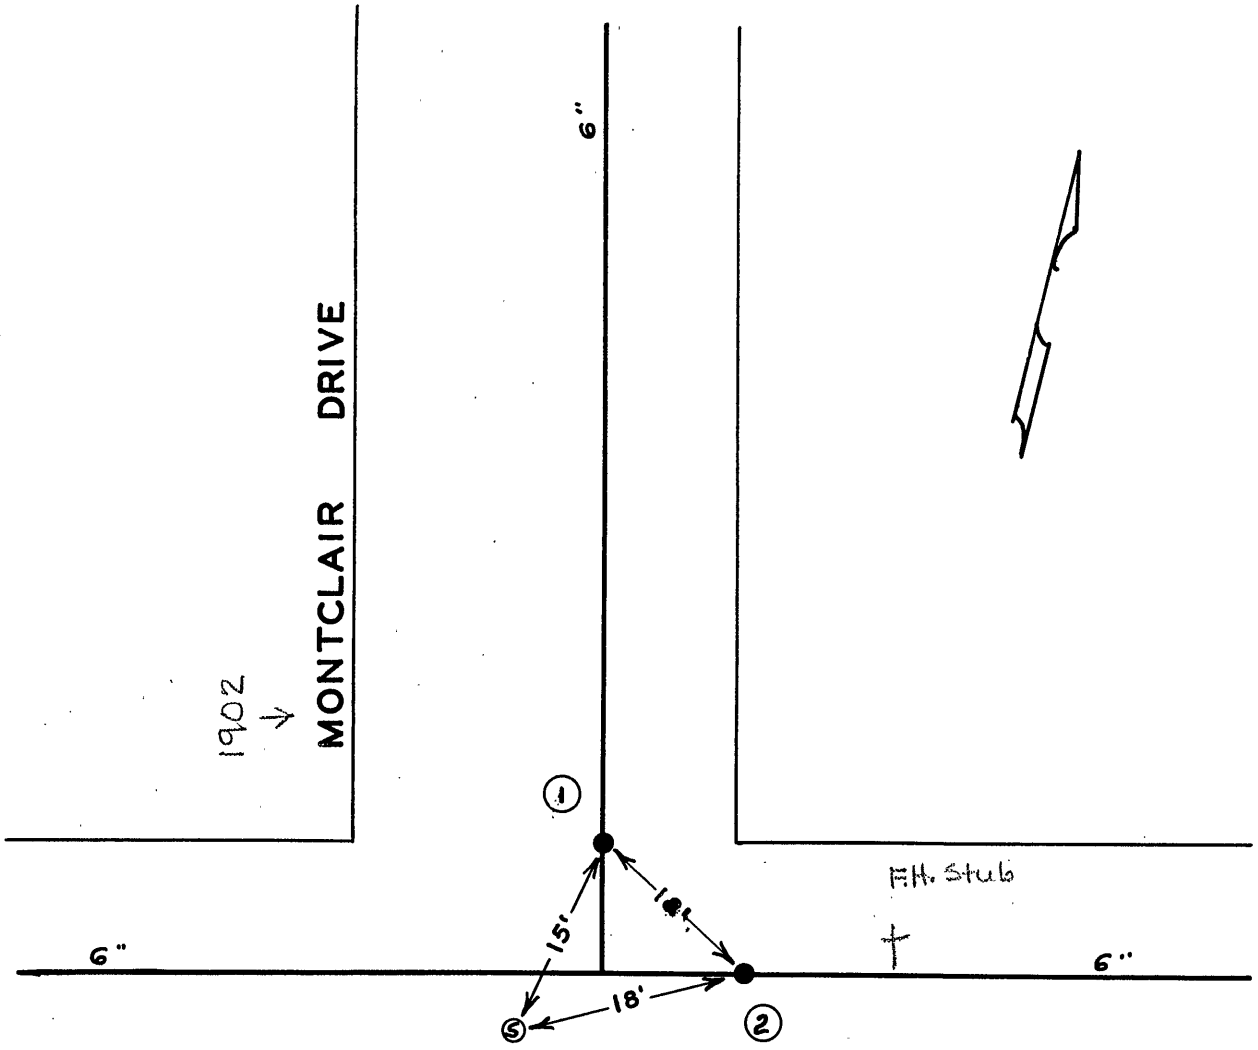

JANDA DRIVE

DATE	NO.	SIZE	MAKE	OPEN	TURNS
11-64	1	6"	DARLING	R	21
11-64	2	6"	DARLING	R	21
	1	0	N.P.L.		
	2	0	E.P.L.		

CITY OF ROANOKE — WATER DEPT.

VALVE DIAGRAM

JANDA DRIVE &

MONTCLAIR DRIVE N.W.

SEC. MAP 47 Roanoke County

DATE PAGE NO.