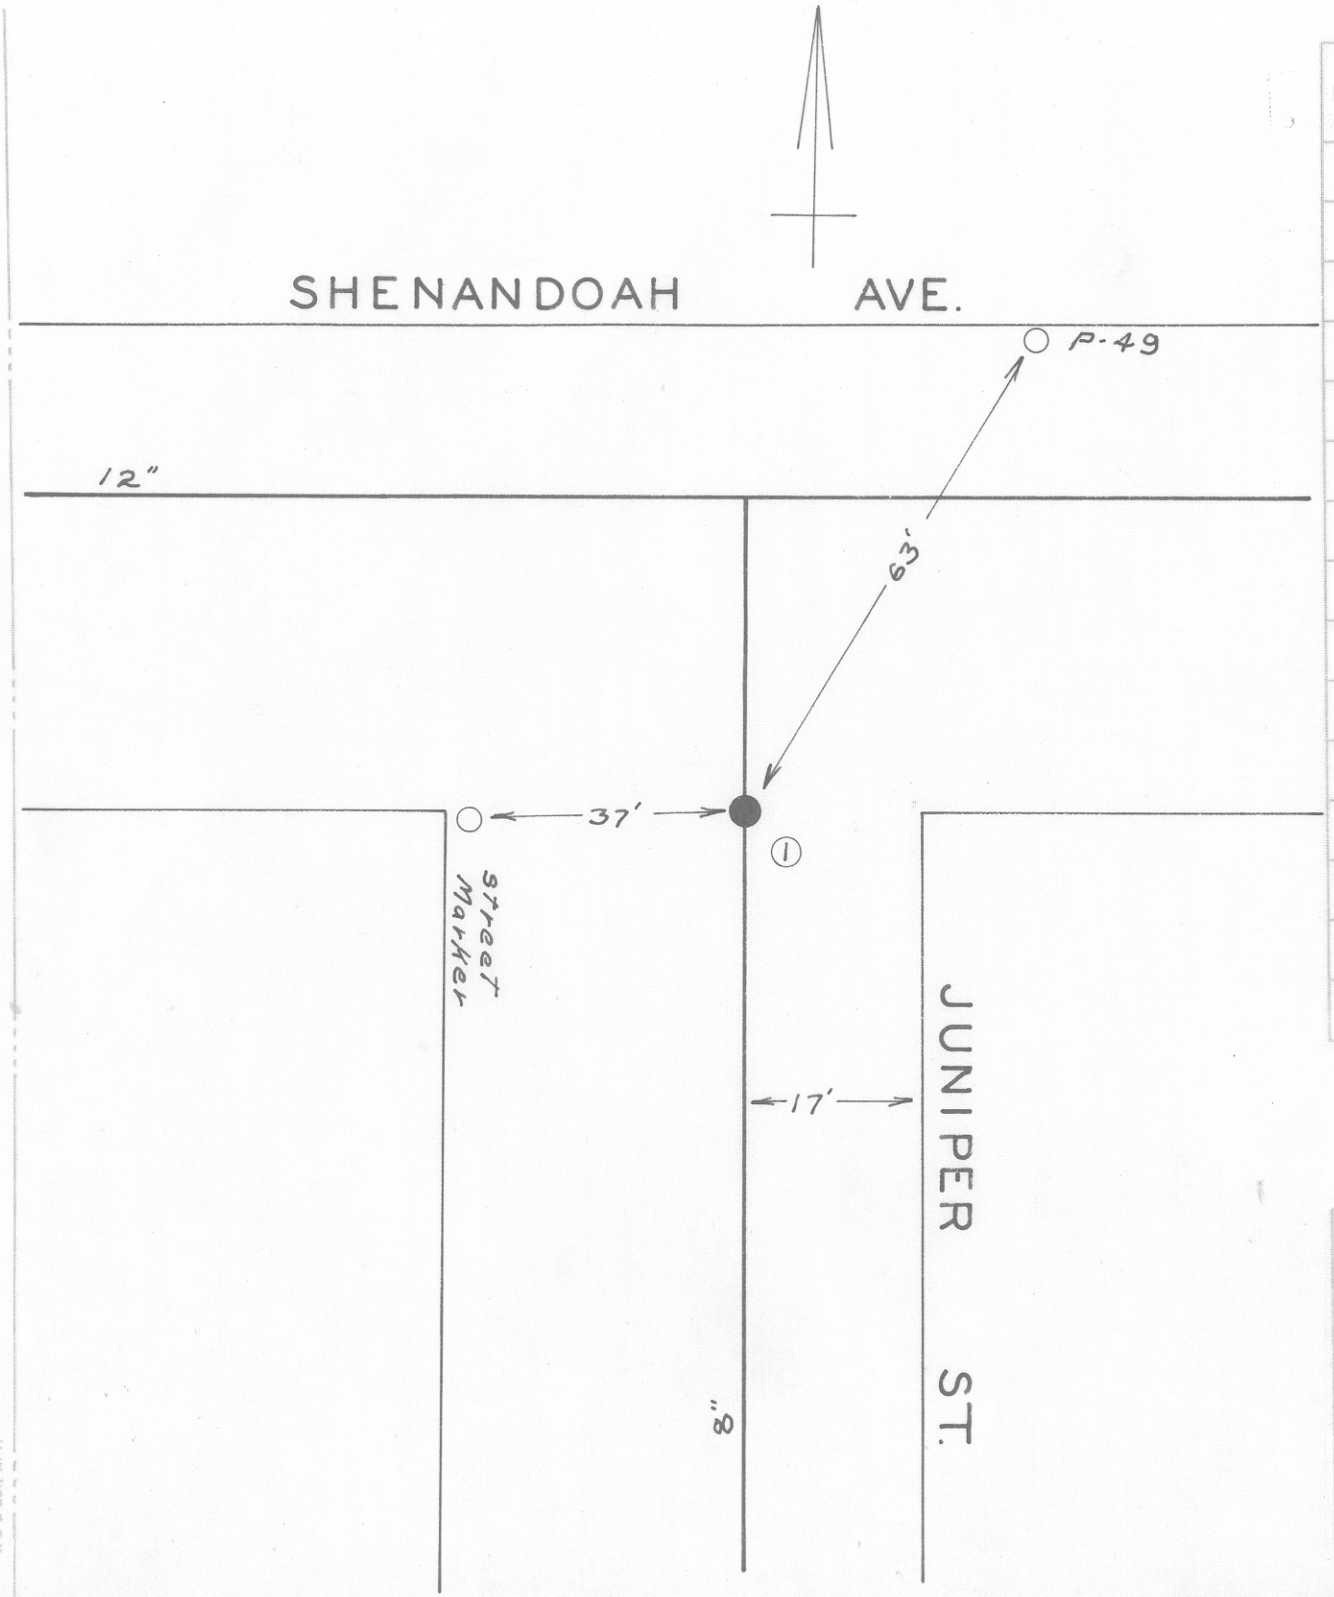

DATE	NO.	SIZE	MAKE	OPEN	TURNS
	1	8"	MUELLER	R	27
	1	0	SPL		

CITY OF ROANOKE — WATER DEPT.

VALVE DIAGRAM

JUNIPER ST. & SHENANDOAH AVE. N. W.

SEC. MAP 263

DATE PAGE NO.

"IMPERIAL" TRACING CLOTH
K & E CO., N. Y.