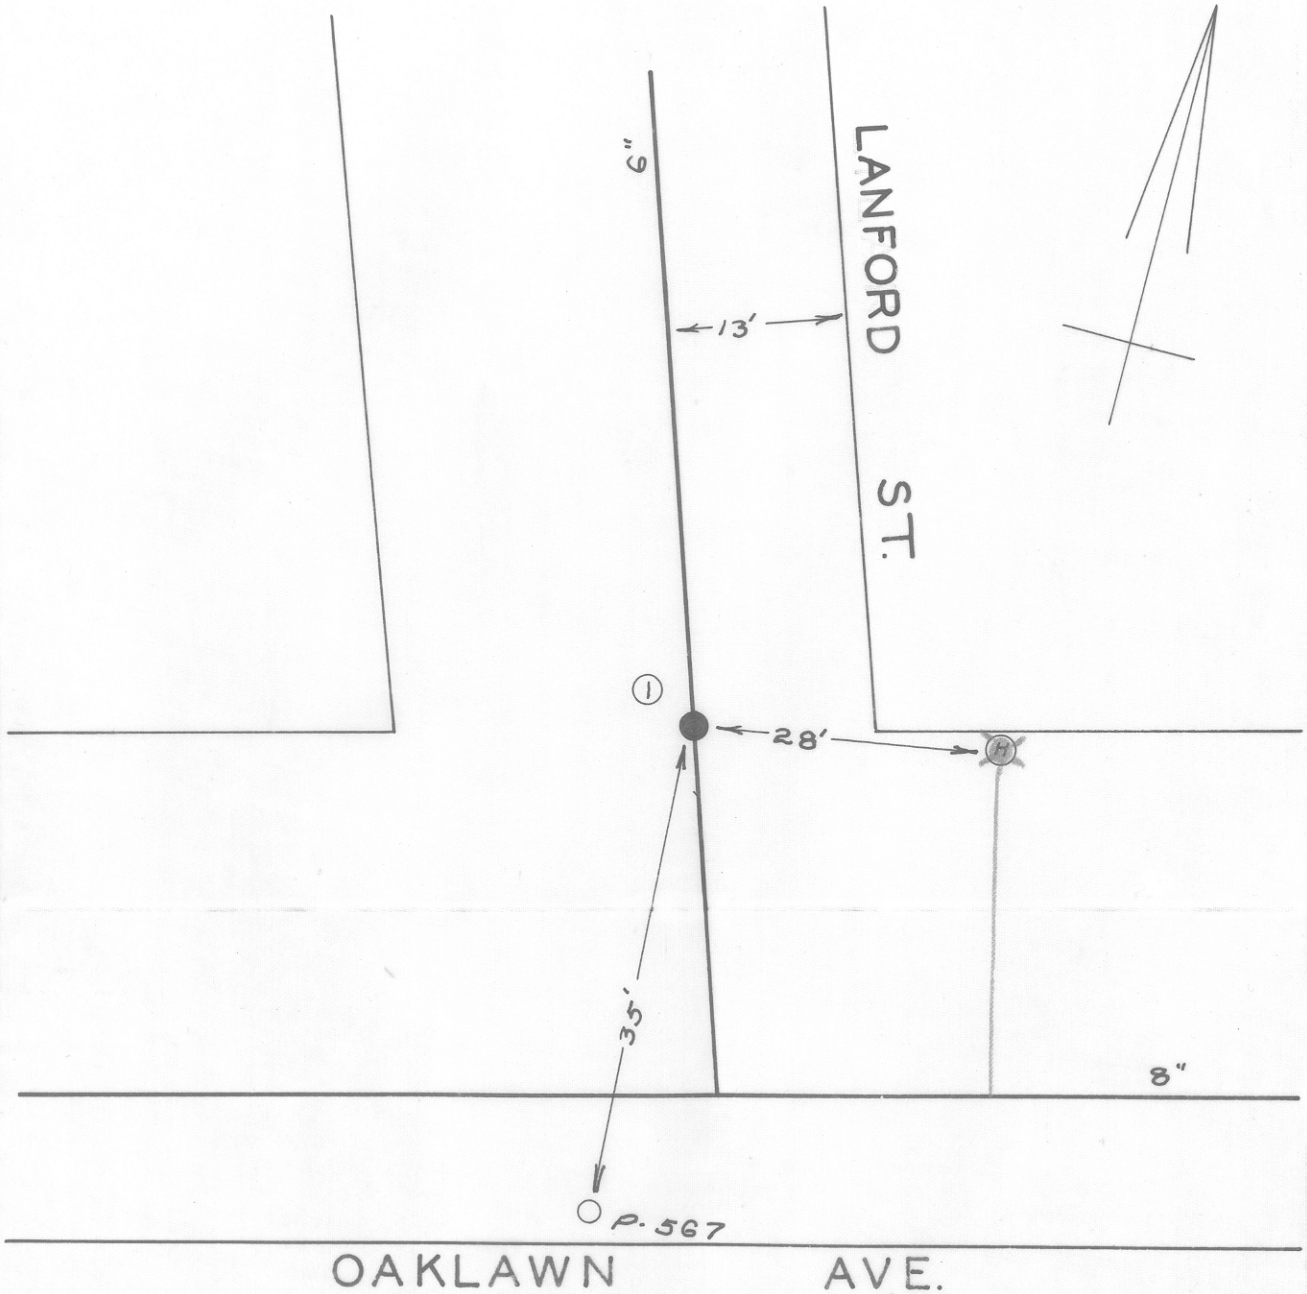

DATE	NO.	SIZE	MAKE	OPEN	TURNS
1952	1	6"		R	21
	1	0	NPL		

CITY OF ROANOKE — WATER DEPT.

VALVE DIAGRAM

LANFORD ST. & OAKLAWN AVE. N. W.

SEC. MAP 217 N.W.

DATE PAGE NO.

"IMPERIAL" TRACING CLOTH
K & E CO., N. Y.