DATE	NO.	SIZE	MAKE	OPEN	TURNS
64	1	2"		R	5 ½

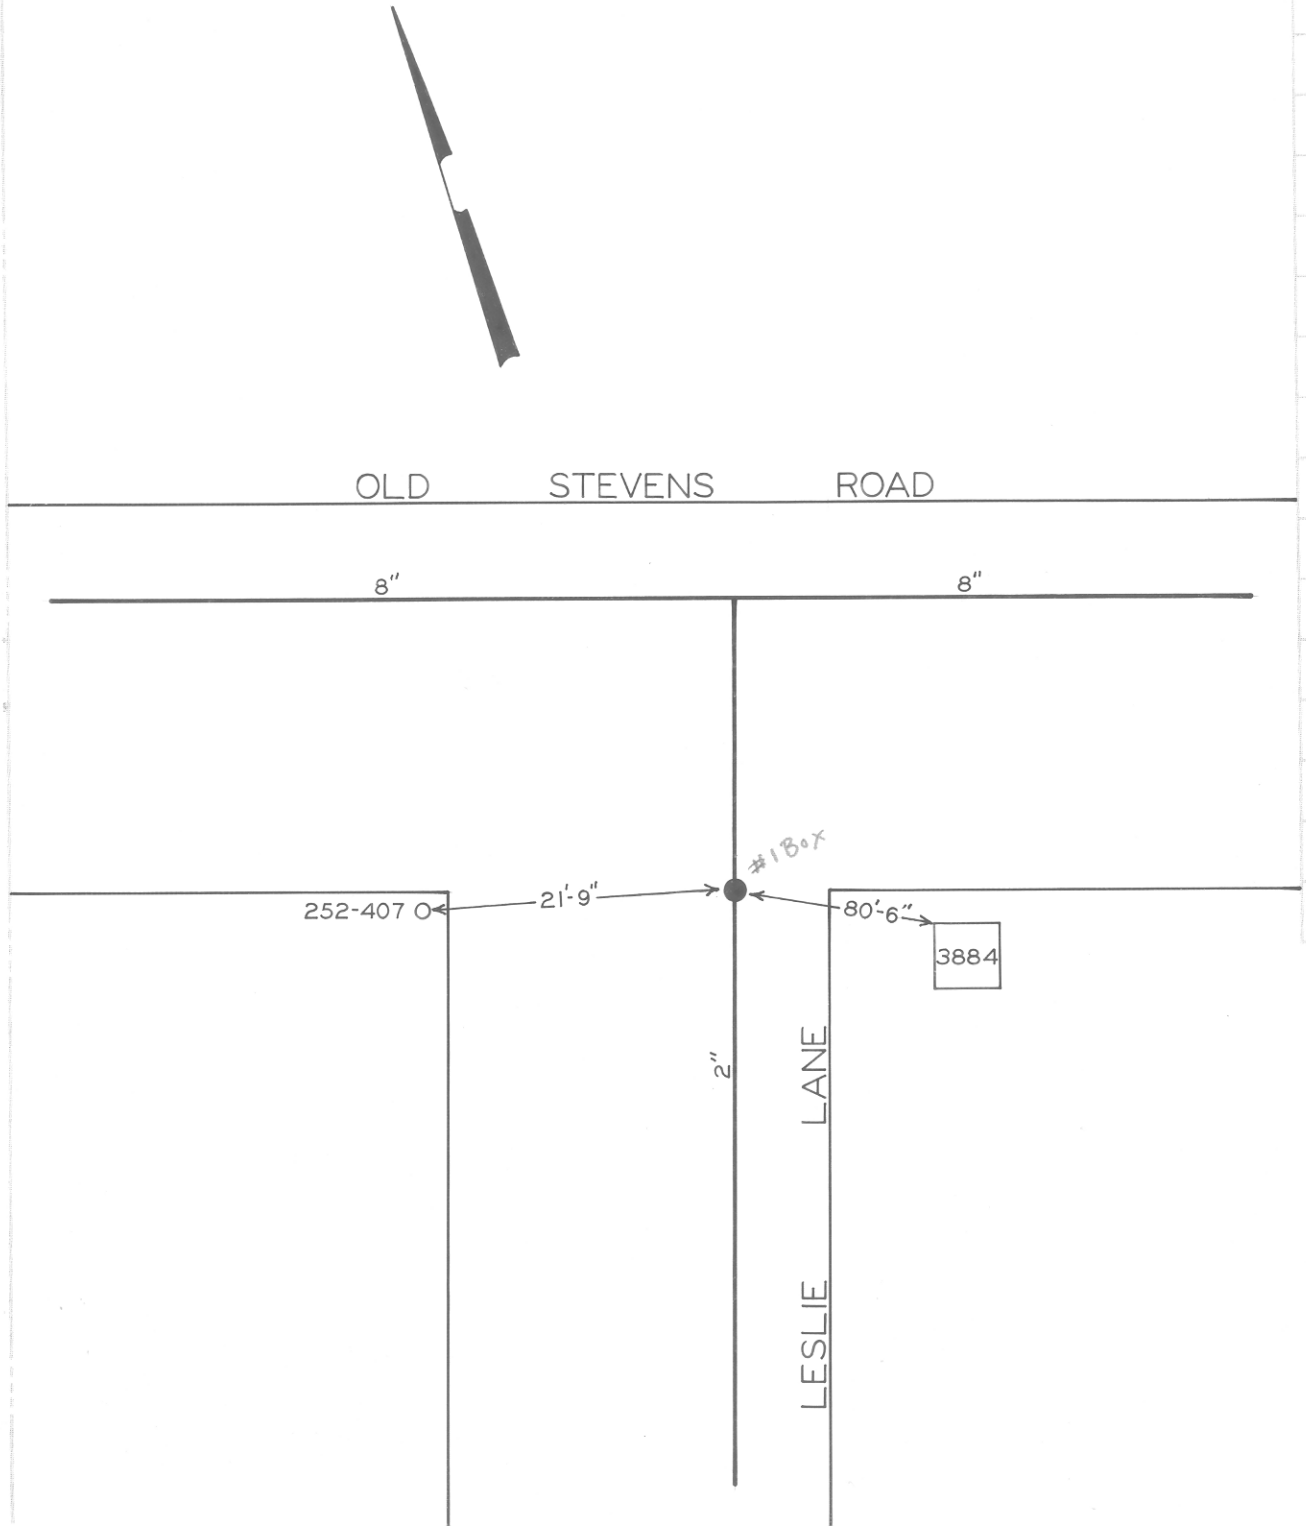

CITY OF ROANOKE—WATER DEP'T

VALVE DIAGRAM

LESLIE LANE & OLD STEVENS ROAD N.W.

SEC. MAP 274

DATE PAGE NO.