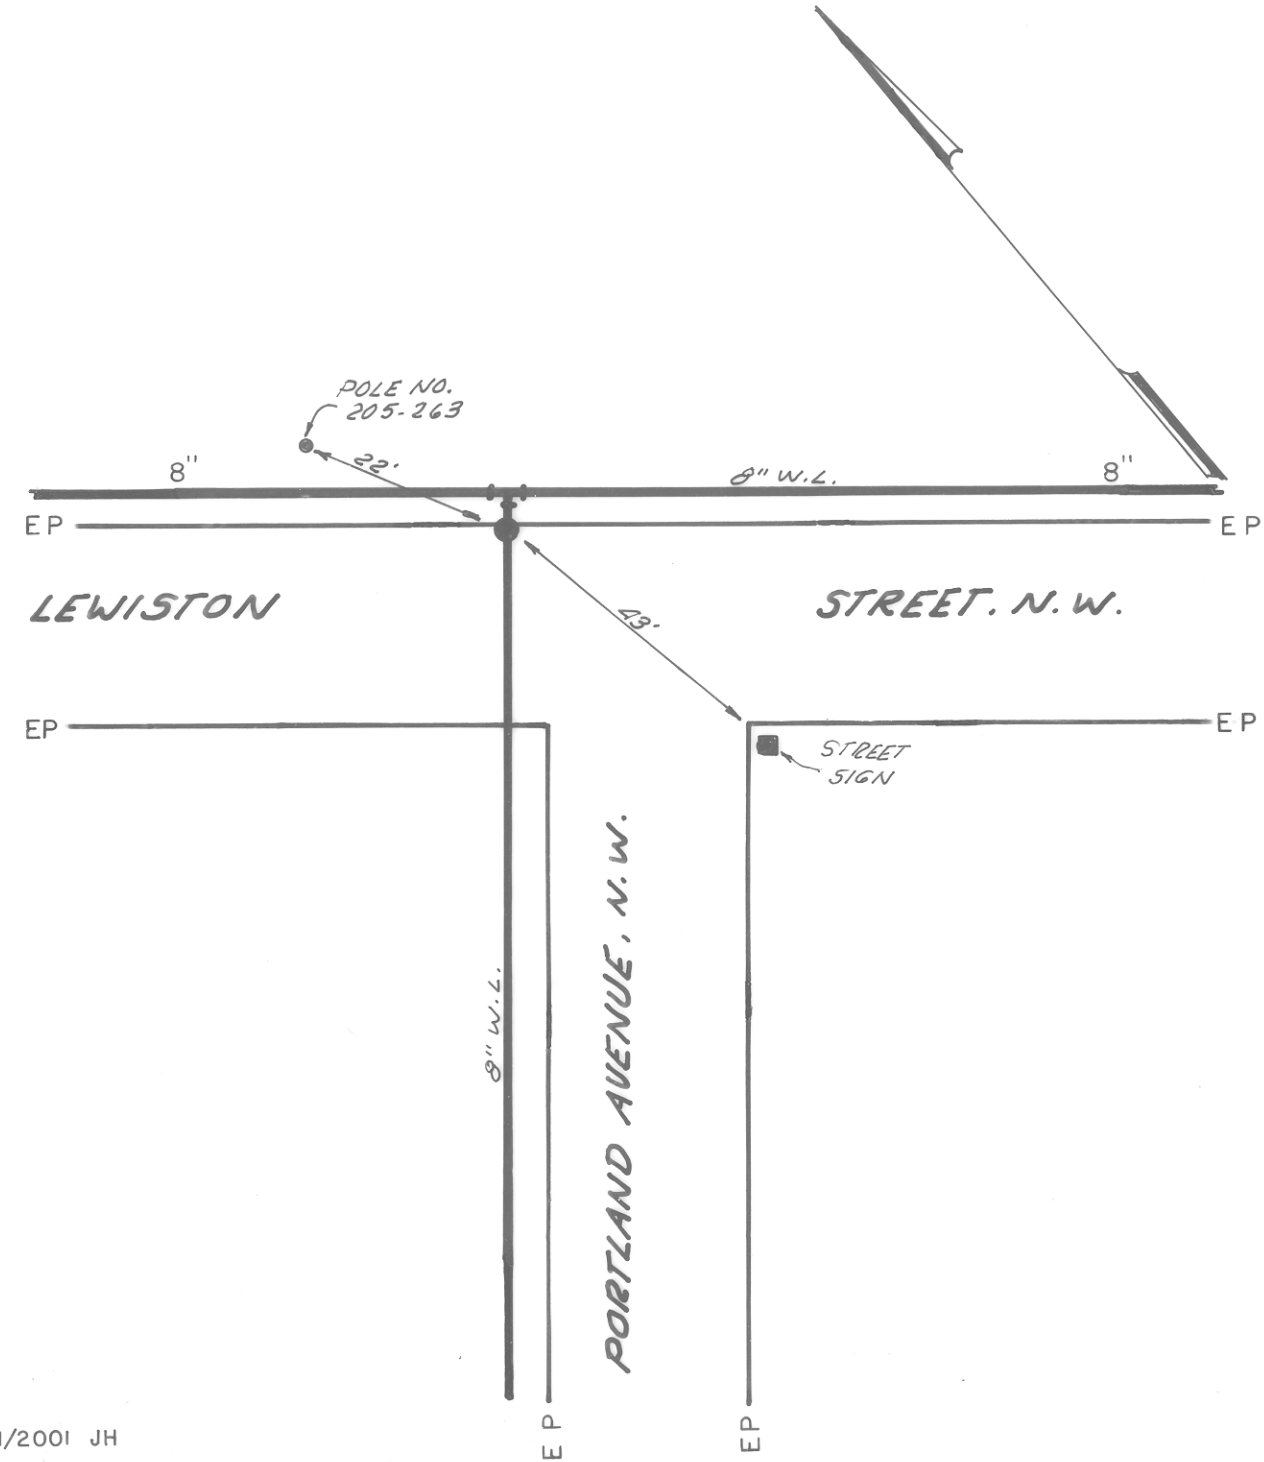

DATE	NO.	SIZE	MAKE	OPEN	TURNS
12/84	1	8"	TAPPING VALVE	R	

1/2001 JH

CITY OF ROANOKE—WATER DEP'T
VALVE DIAGRAM
LEWISTON STREET &
PORTLAND AVENUE, N.W.
SEC. MAP 642
DATE 4-9-85 PAGE NO.