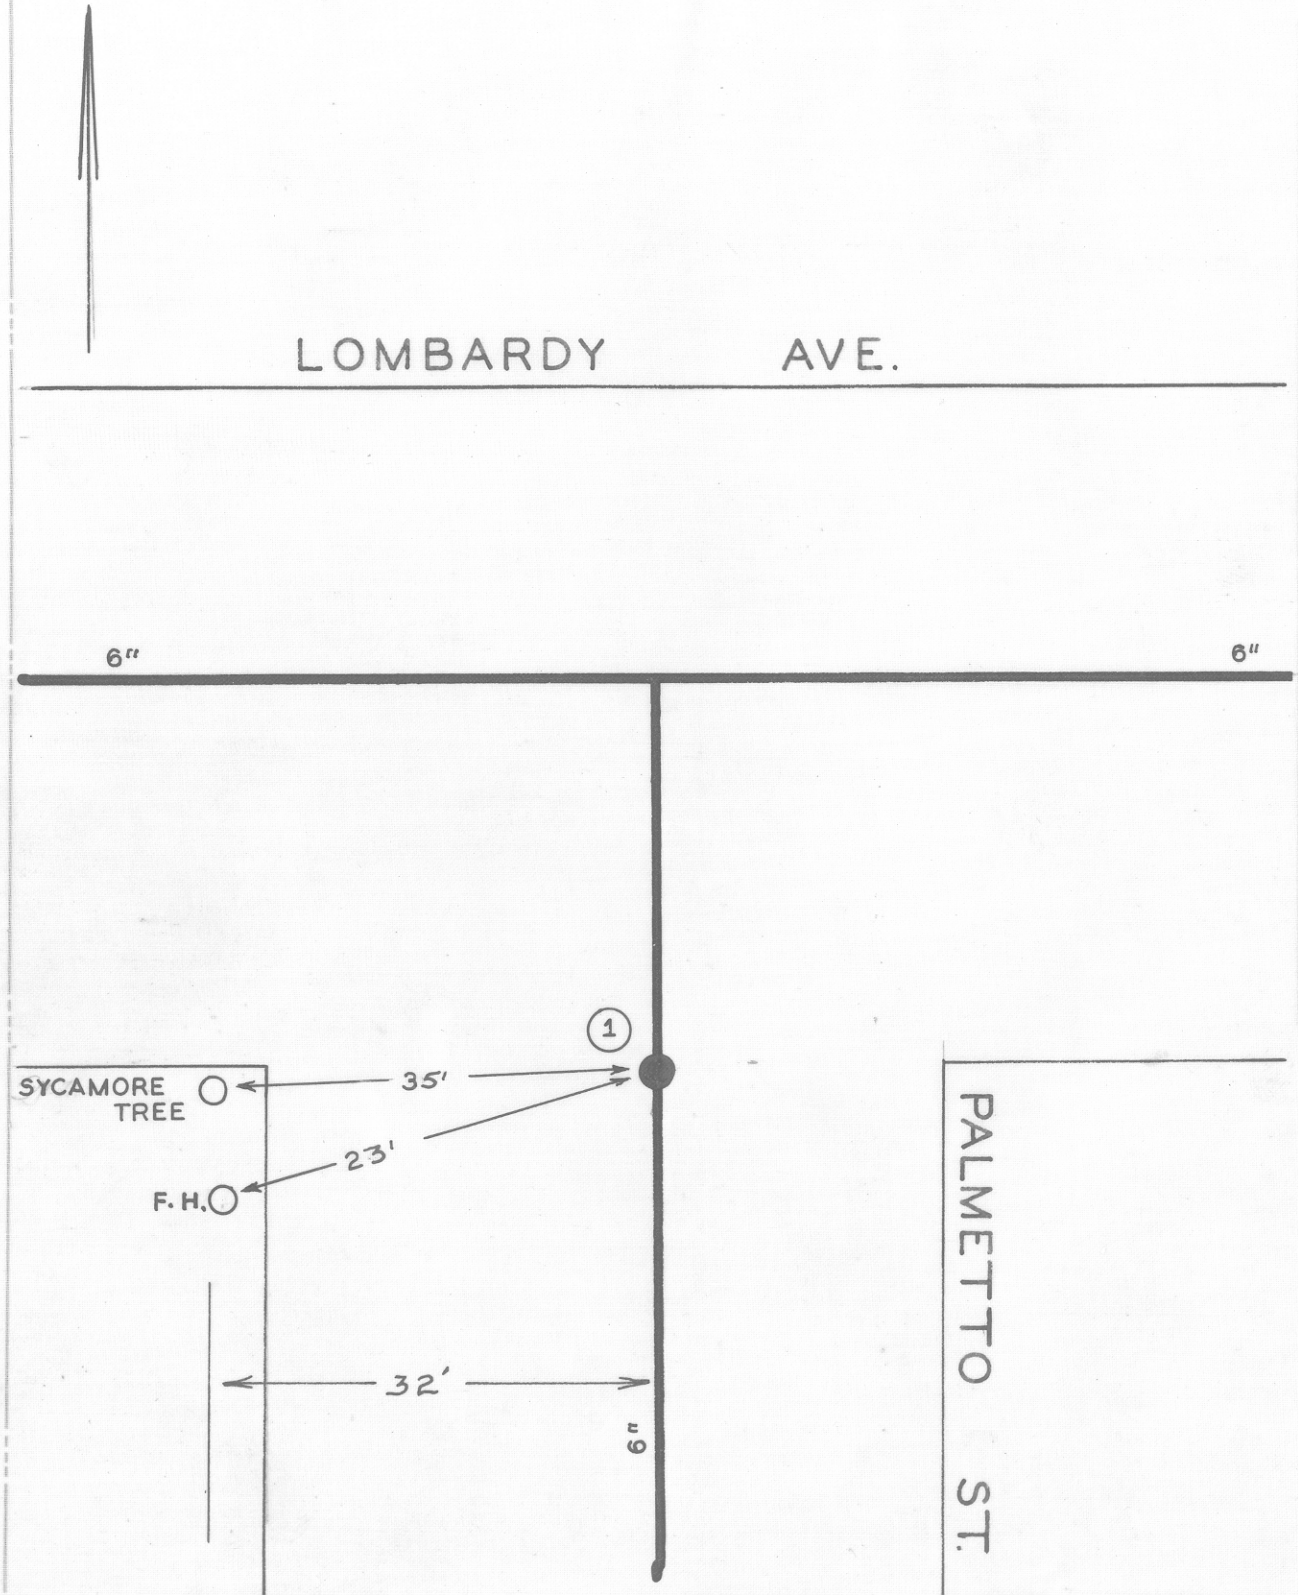

DATE	NO.	SIZE	MAKE	OPEN	TURNS
1947	1	6"	DARLING	R	21
	1	6'-N	SPL		

CITY OF ROANOKE—WATER DEP'T

VALVE DIAGRAM

LOMBARDY AVENUE & PALMETTO STREET N.W.

SEC. MAP 254

DATE 6/15/45 PAGE NO. N.W.291