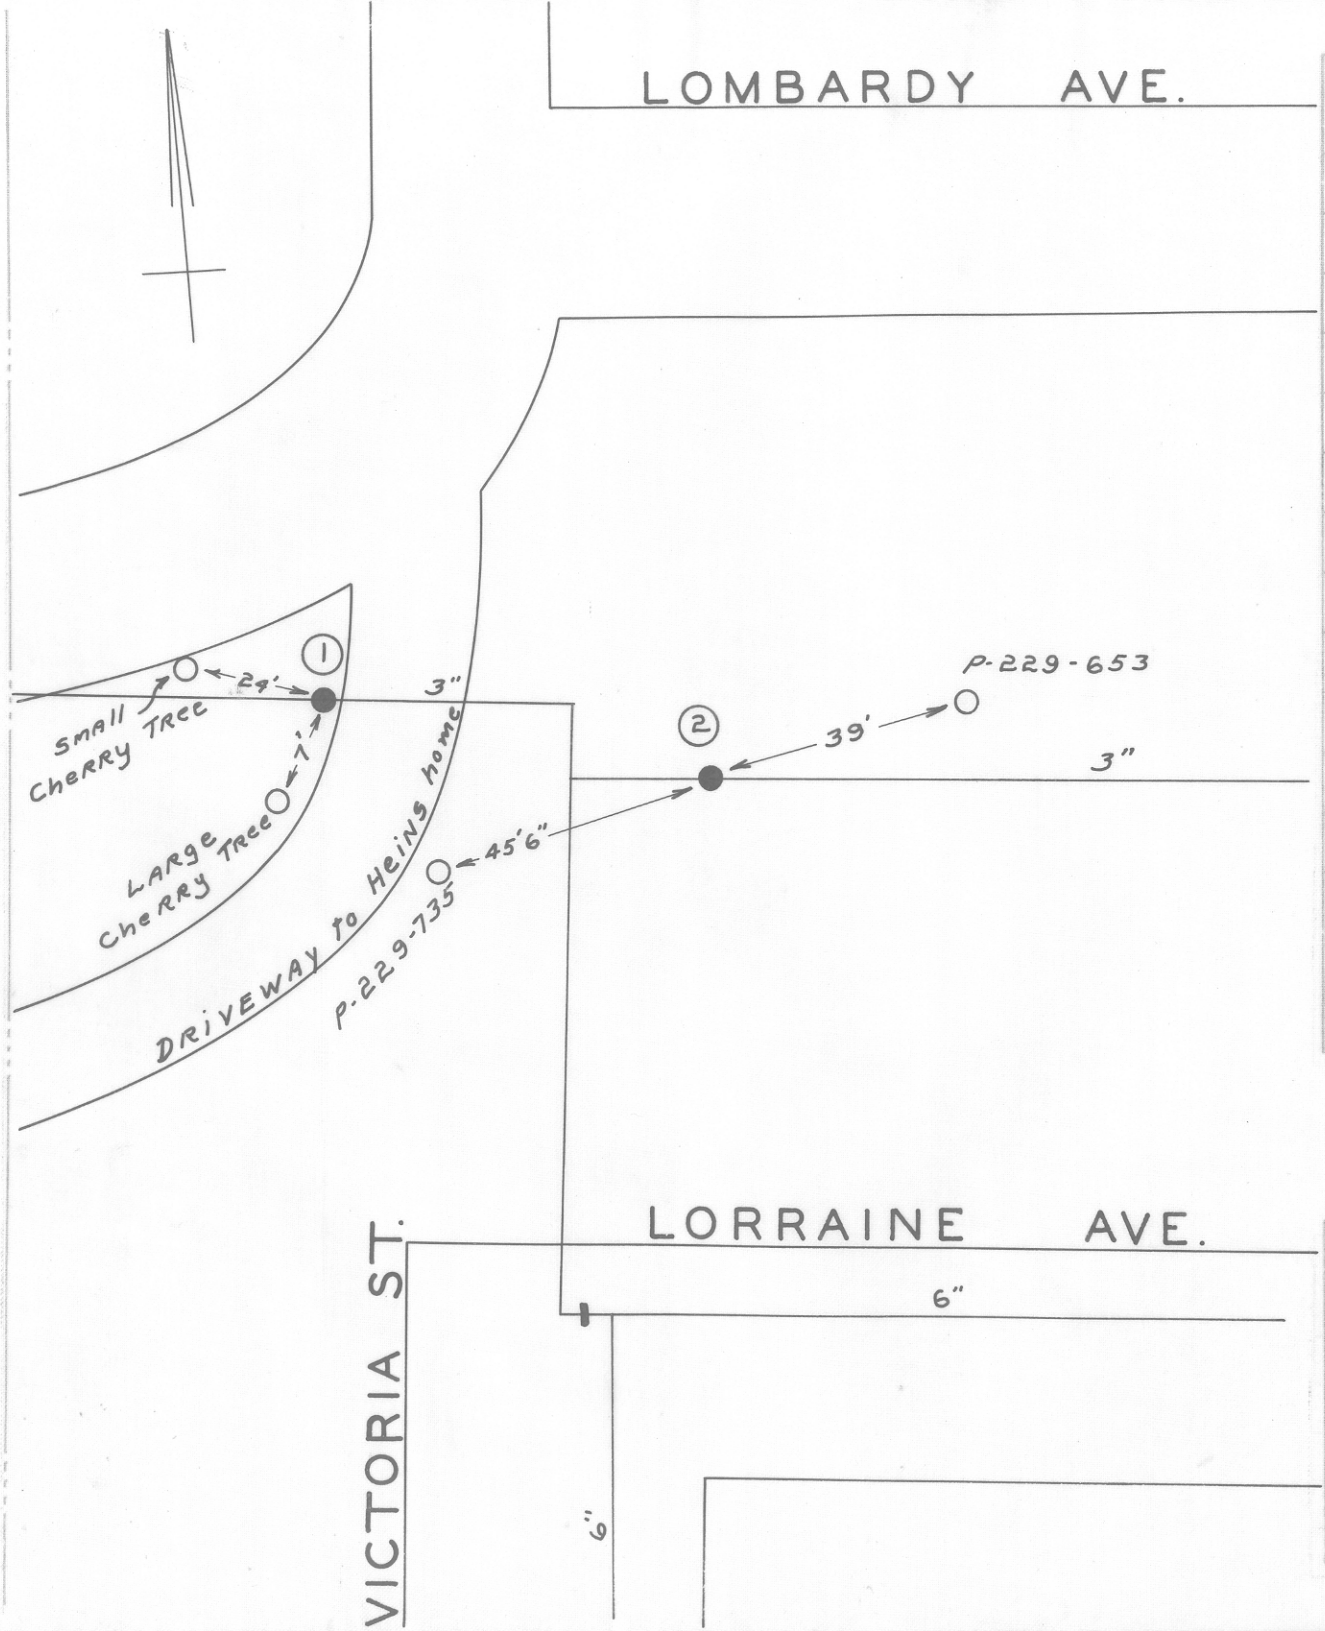

DATE	NO.	SIZE	MAKE	OPEN	TURNS
	1	3"			
	2	3"			

CITY OF ROANOKE — WATER DEPT.

VALVE DIAGRAM

S. OF LOMBARDY AVE. N.W.

AT DRIVEWAY TO HEINS

ESTATE

SEC. MAP 243

DATE PAGE NO.

"IMPERIAL" TRACING CLOTH
K & E CO., N.Y.