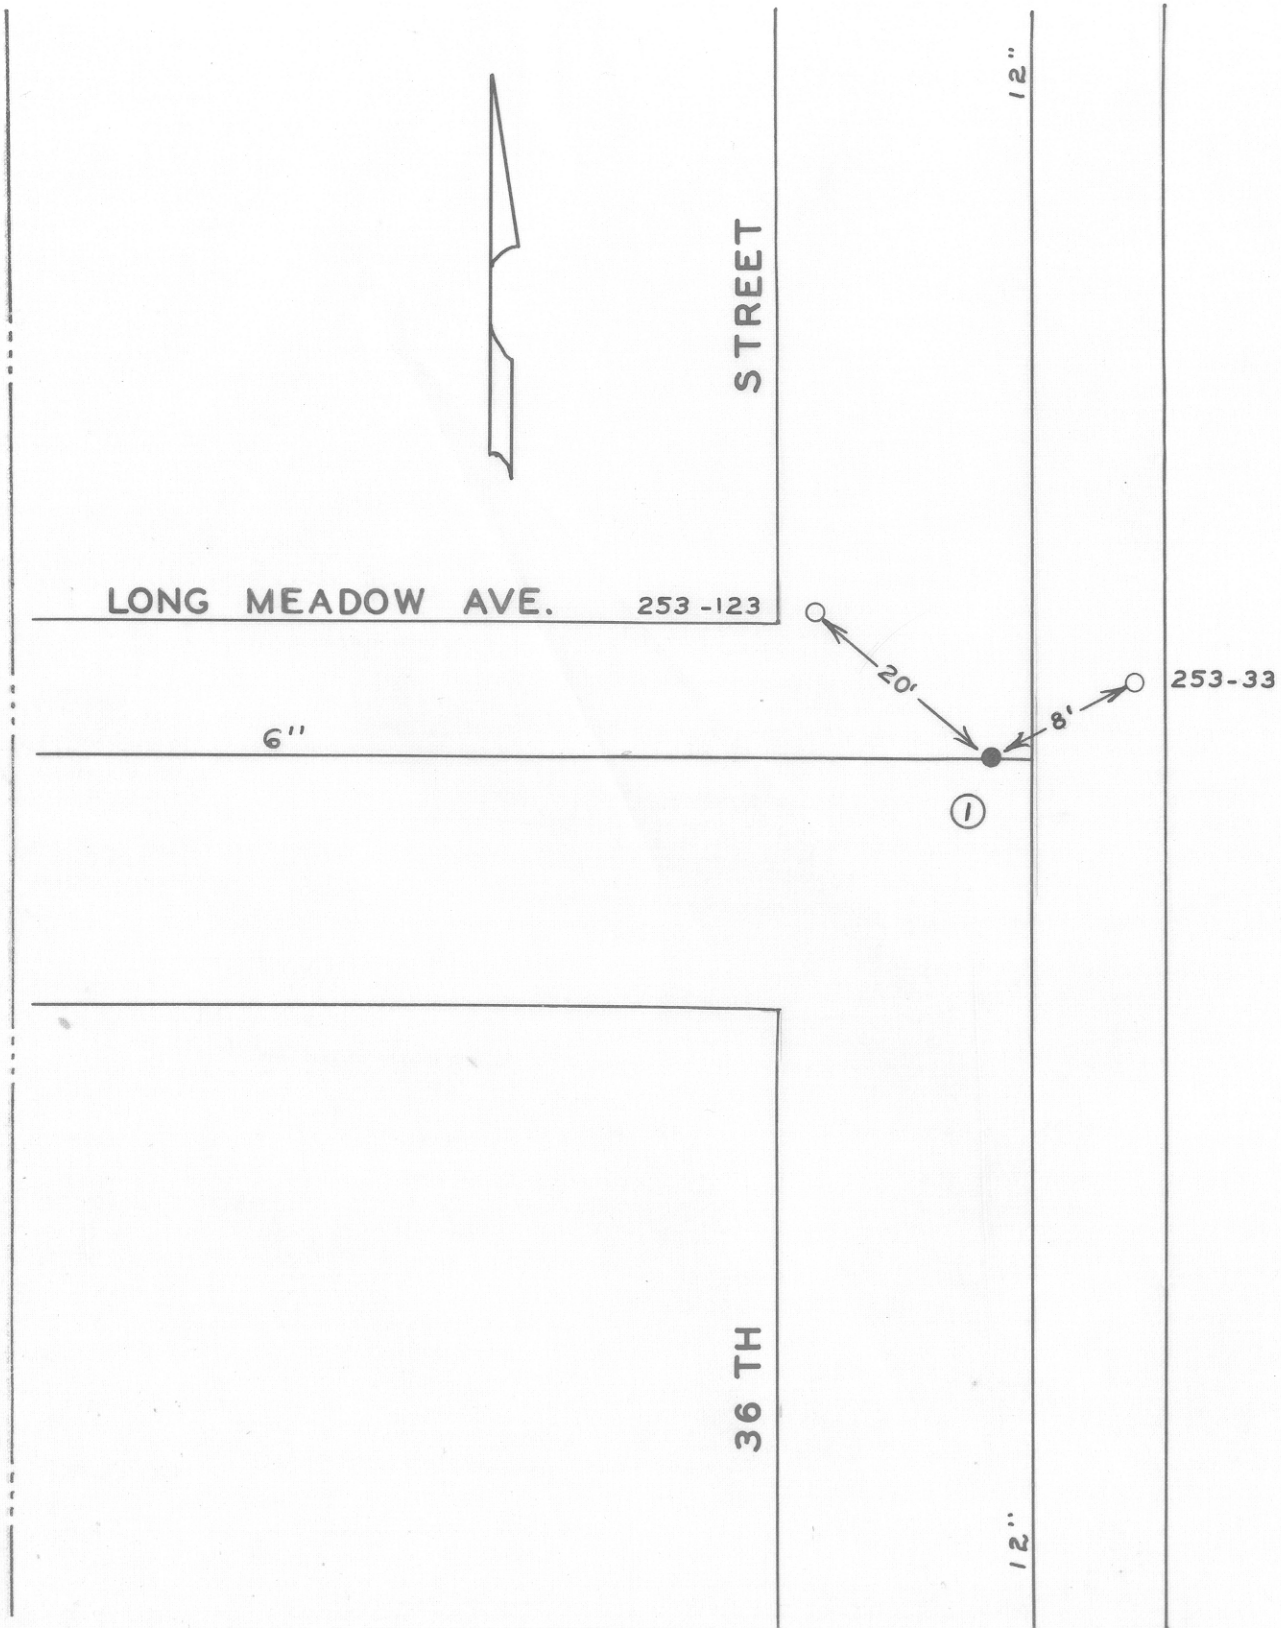

DATE	NO.	SIZE	MAKE	OPEN	TURNS
10-65	1	6	DARLING	R	

CITY OF ROANOKE — WATER DEPT.

VALVE DIAGRAM

LONG MEADOW AVENUE &

36TH STREET N.W.

SEC. MAP 264

DATE PAGE NO.