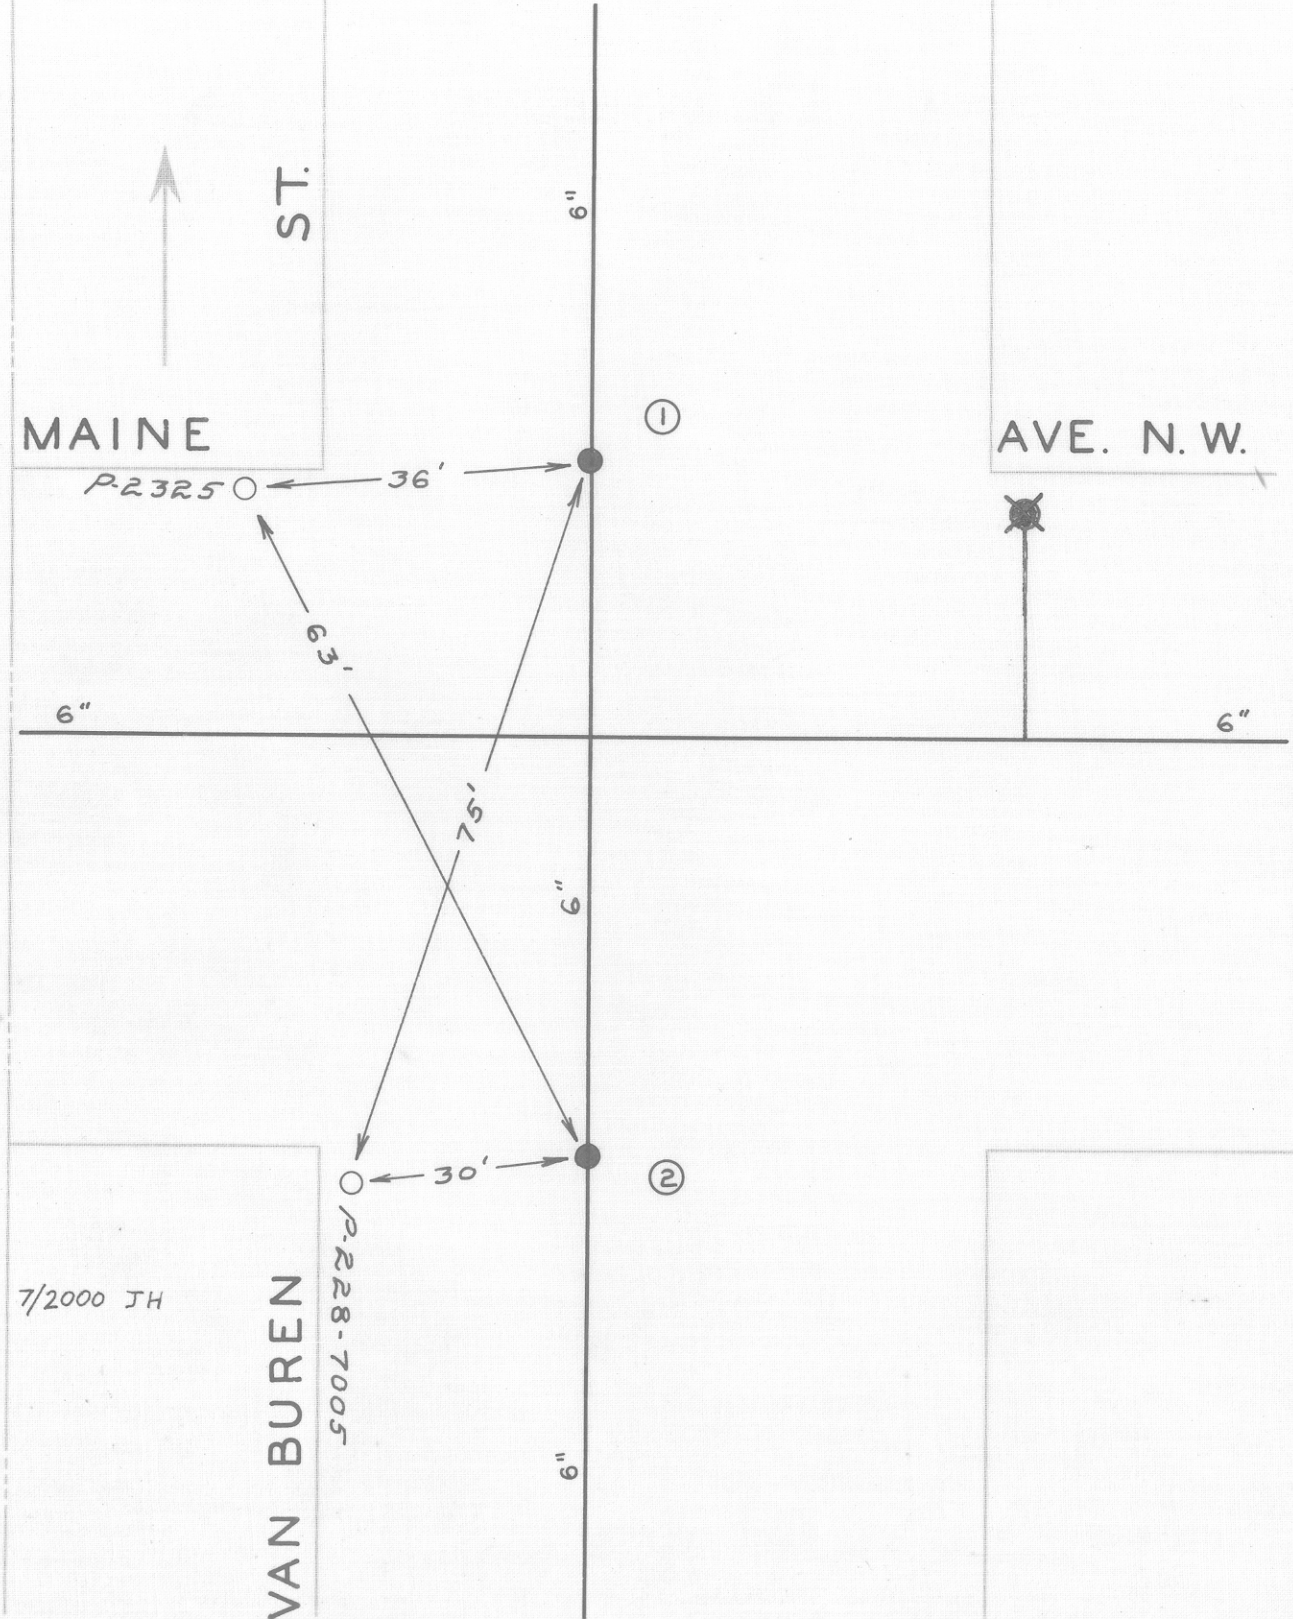

DATE	NO.	SIZE	MAKE	OPEN	TURNS
1955	1	6"	MUELLER	R	
1955	2	6"	MUELLER	R	

7/2000 JH

CITY OF ROANOKE—WATER DEP'T

VALVE DIAGRAM

MAINE AVE. & VAN BUREN ST. N. W.

SEC. MAP 277, 276

DATE PAGE NO.