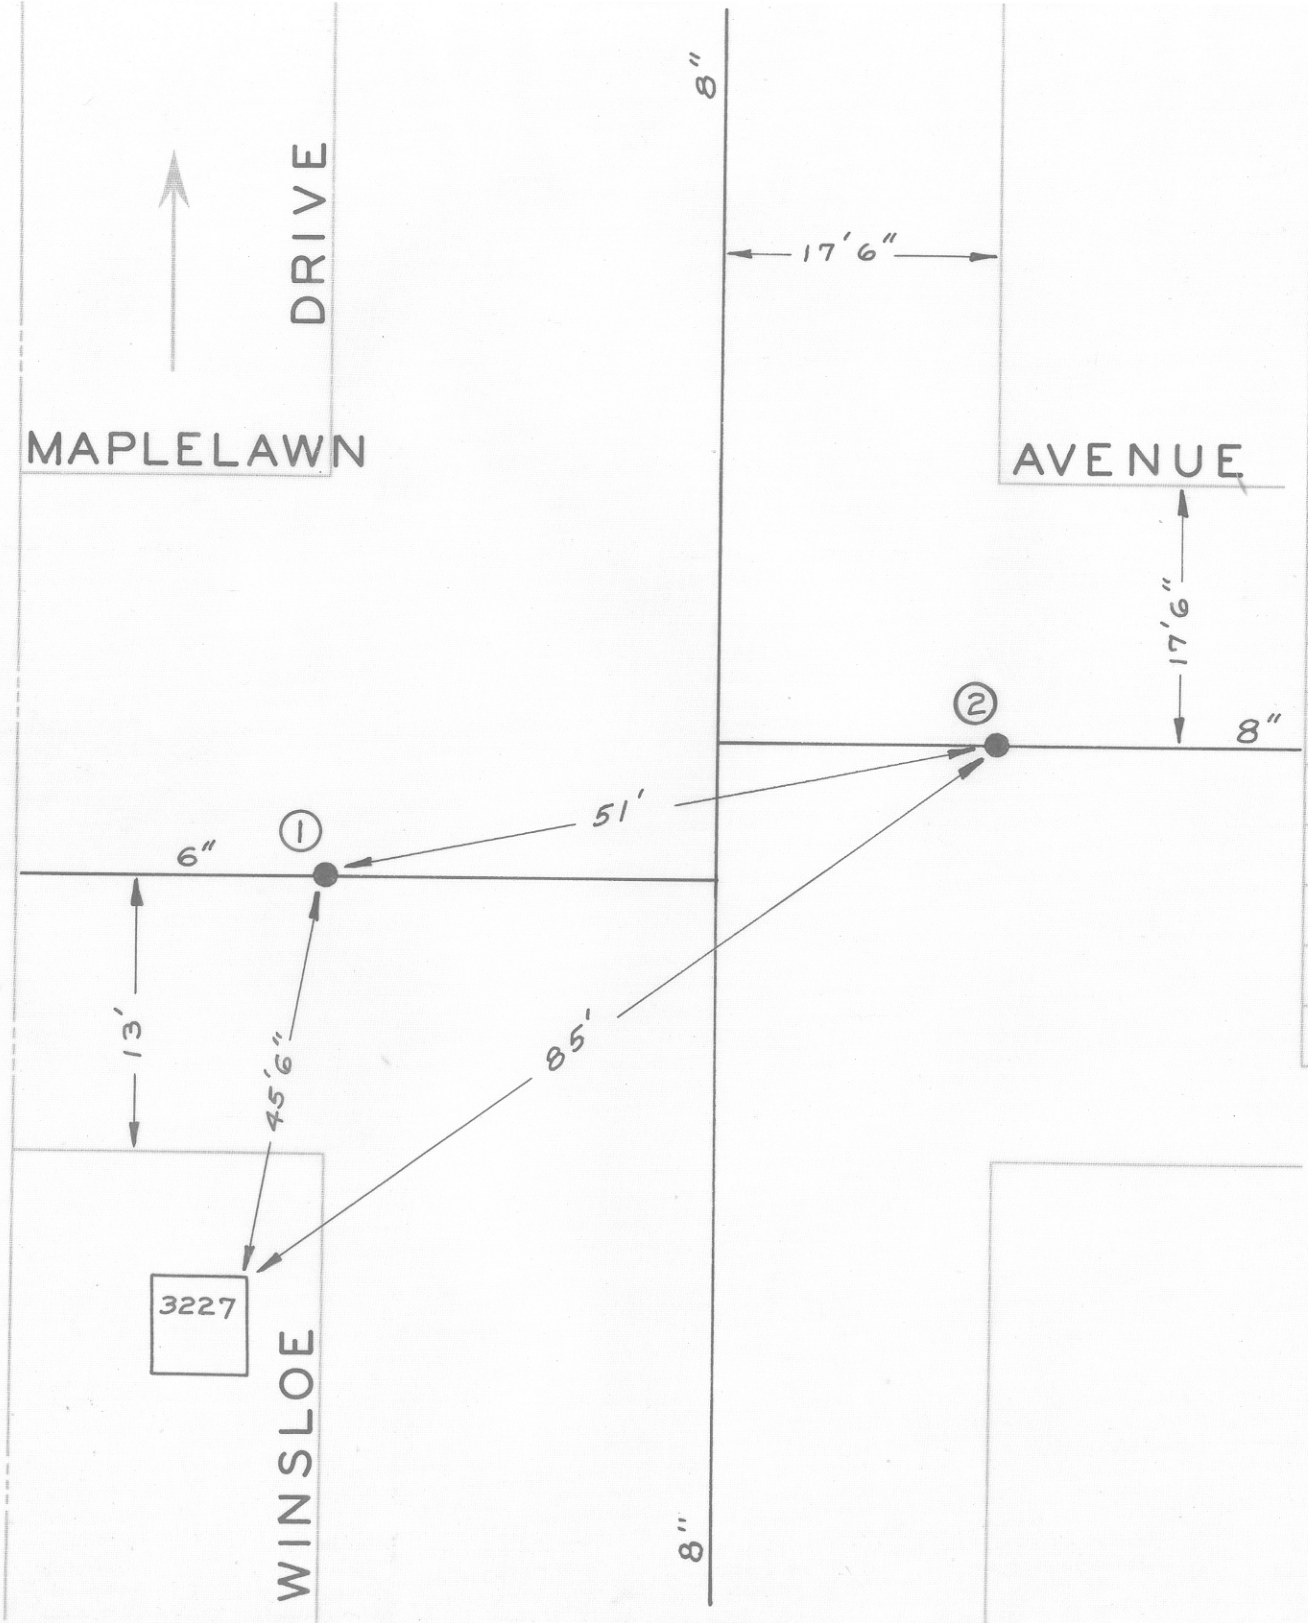

DATE	NO.	SIZE	MAKE	OPEN	TURNS
'59	1	6"	MUELLER	R	20
'59	2	8"	DARLING	R	26
	1	0	W PL		
	2	0	E PL		

CITY OF ROANOKE—WATER DEP'T

VALVE DIAGRAM

MAPLELAWN AVE. &
WINSLOE DR. N.W.

SEC. MAP 217

DATE PAGE NO.