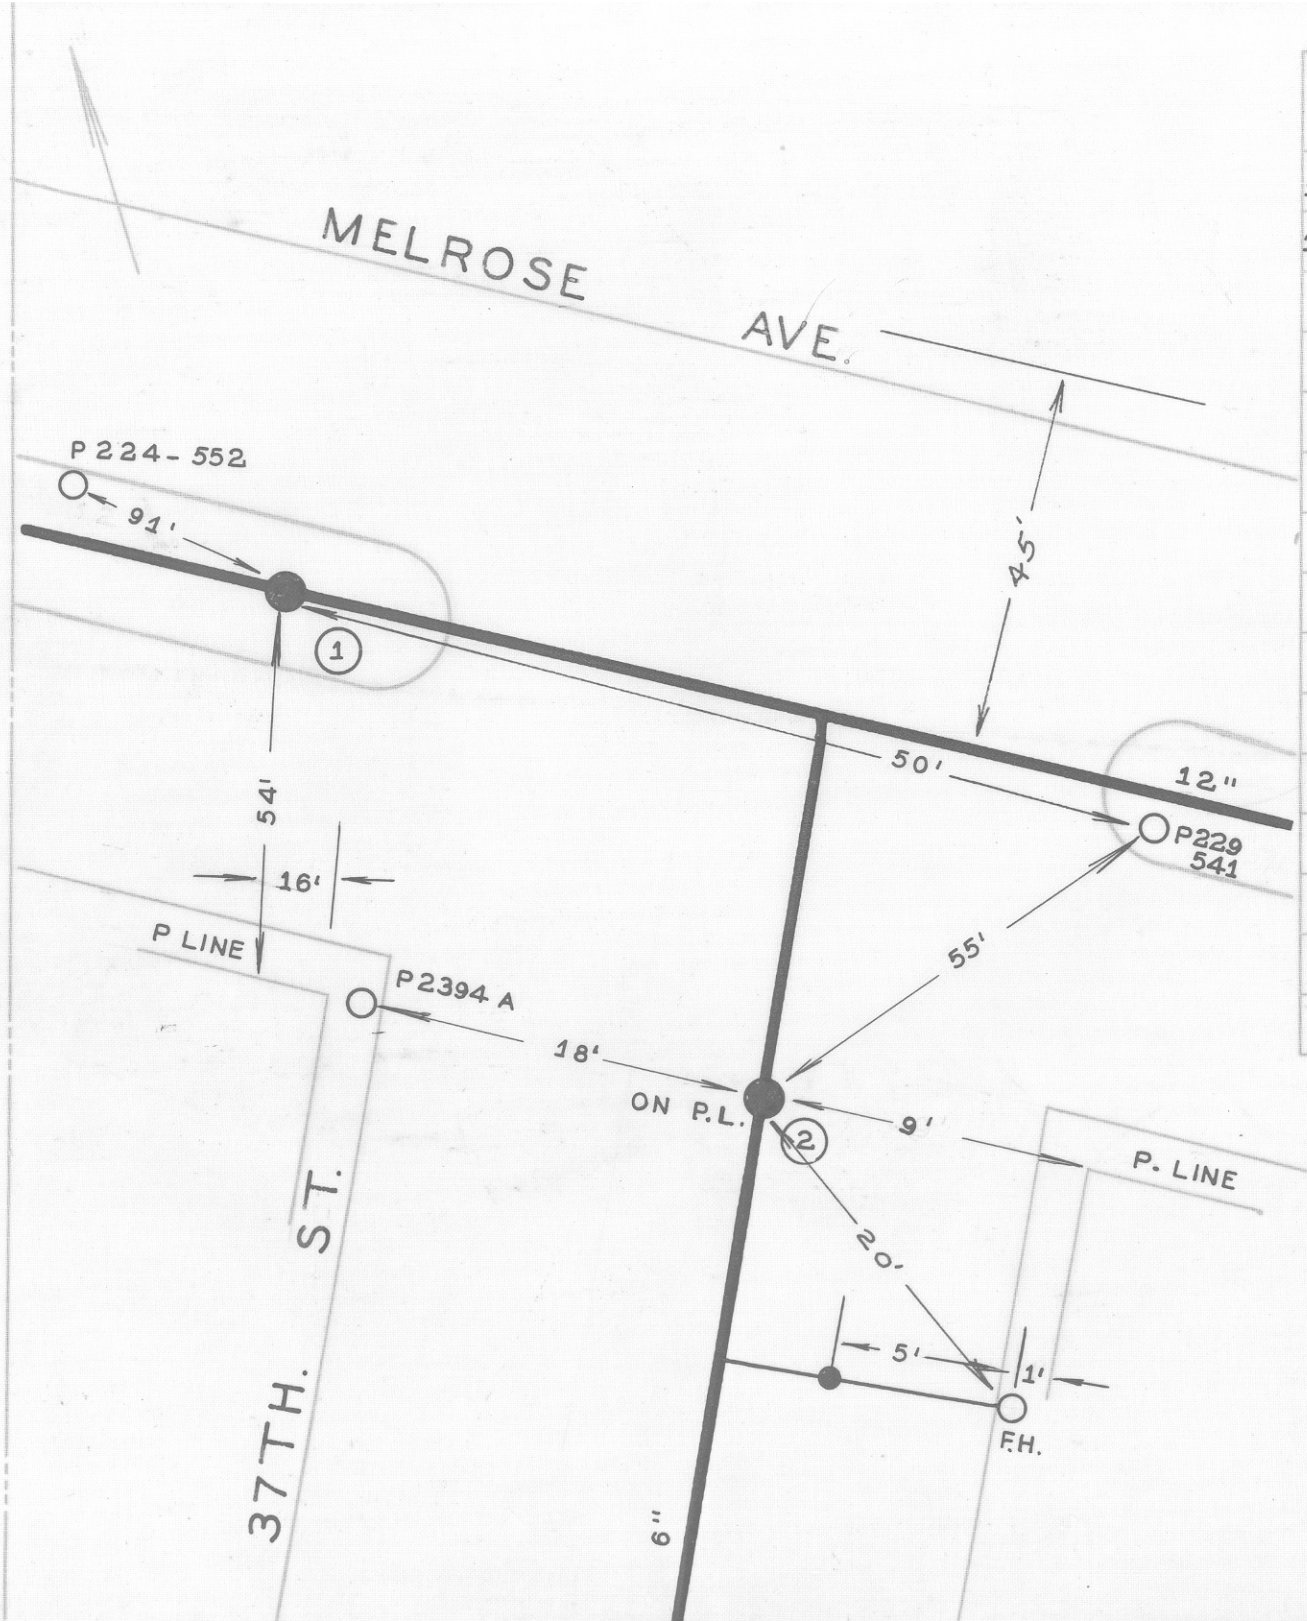

DATE	NO.	SIZE	MAKE	OPEN	TURNS
1950	1	12"	DARLING	R	391/2
1950	2	6"	DARLING	R	201/2
	1	12'-W	WPL		
	2	0	SPL		

CITY OF ROANOKE—WATER DEP'T

VALVE DIAGRAM

MELROSE AVENUE & 37TH. STREET N.W. 35TH. ST. ON ST. MARKER

SEC. MAP 266

DATE

PAGE NO. N.W.360