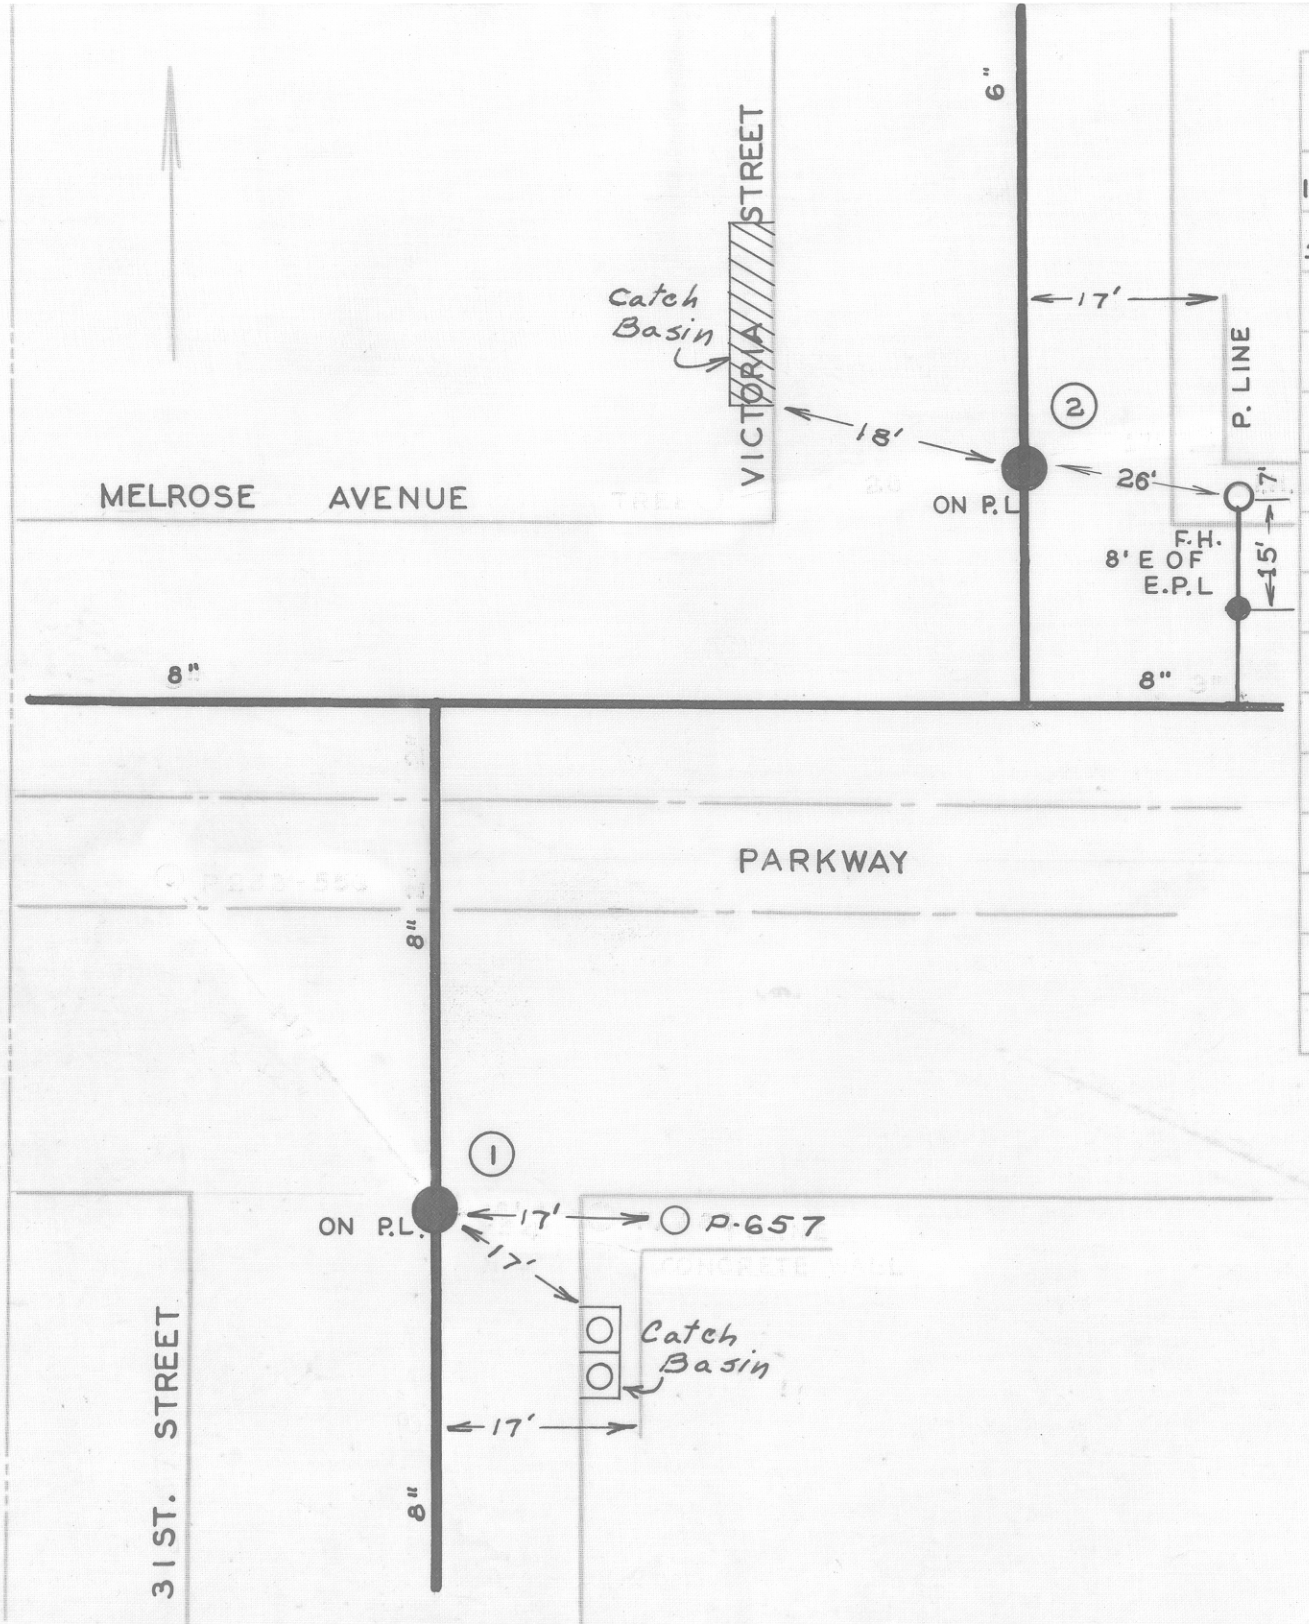

DATE	NO.	SIZE	MAKE	OPEN	TURNS
1946	1	8"	DARLING	R	27
1949	2	6"	DARLING	R	20
	1	10'-N	SPL		
	2	0	NPL		

CITY OF ROANOKE—WATER DEP'T

VALVE DIAGRAM

MELROSE AVE., VICTORIA STREET & 31ST. ST. N.W.

SEC. MAP 253

DATE 4/22/46 PAGE NO. N.W. 281