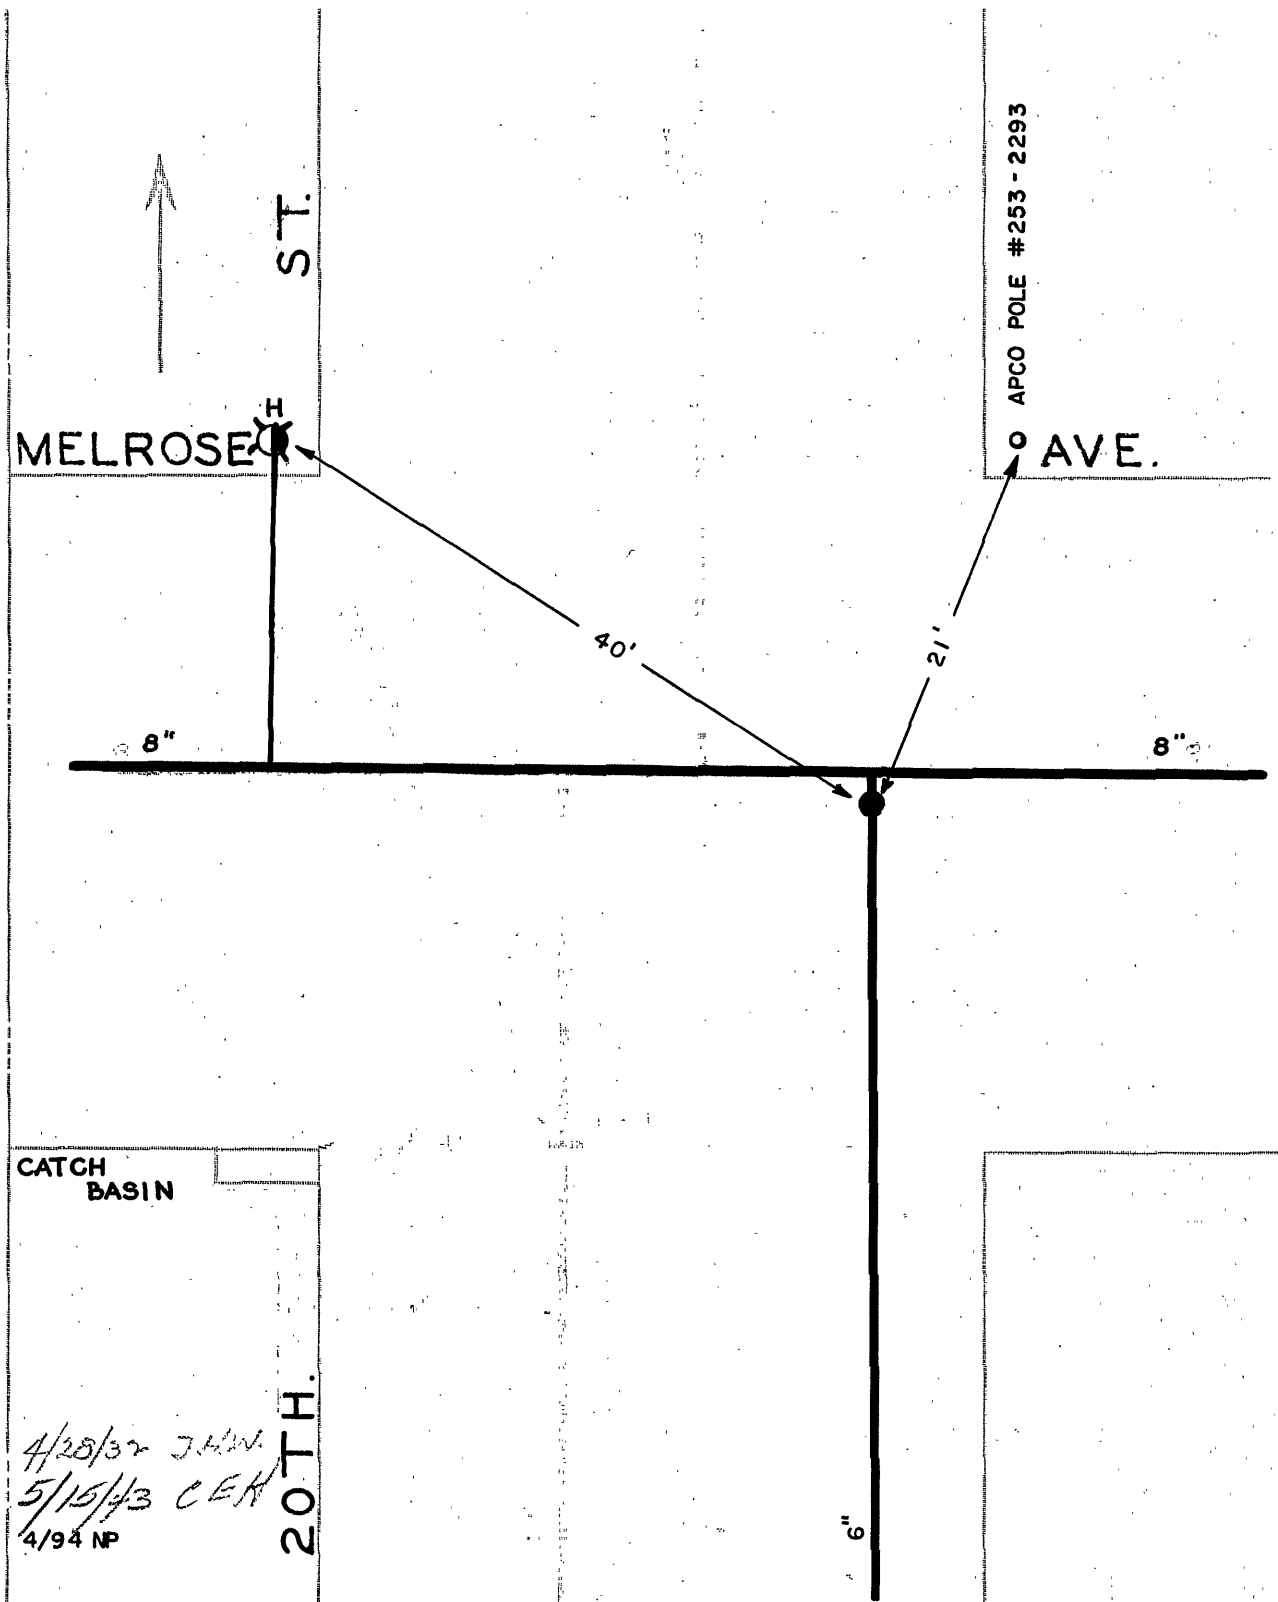

DATE	NO.	SIZE	MAKE	OPEN	TURNS
1993	1	6"	MUELLER	R	

CITY OF ROANOKE—WATER DEPT

VALVE DIAGRAM

MELROSE AVE. & 20TH. ST. N.W.

SEC. MAP 232

DATE

PAGE NO. NW 202