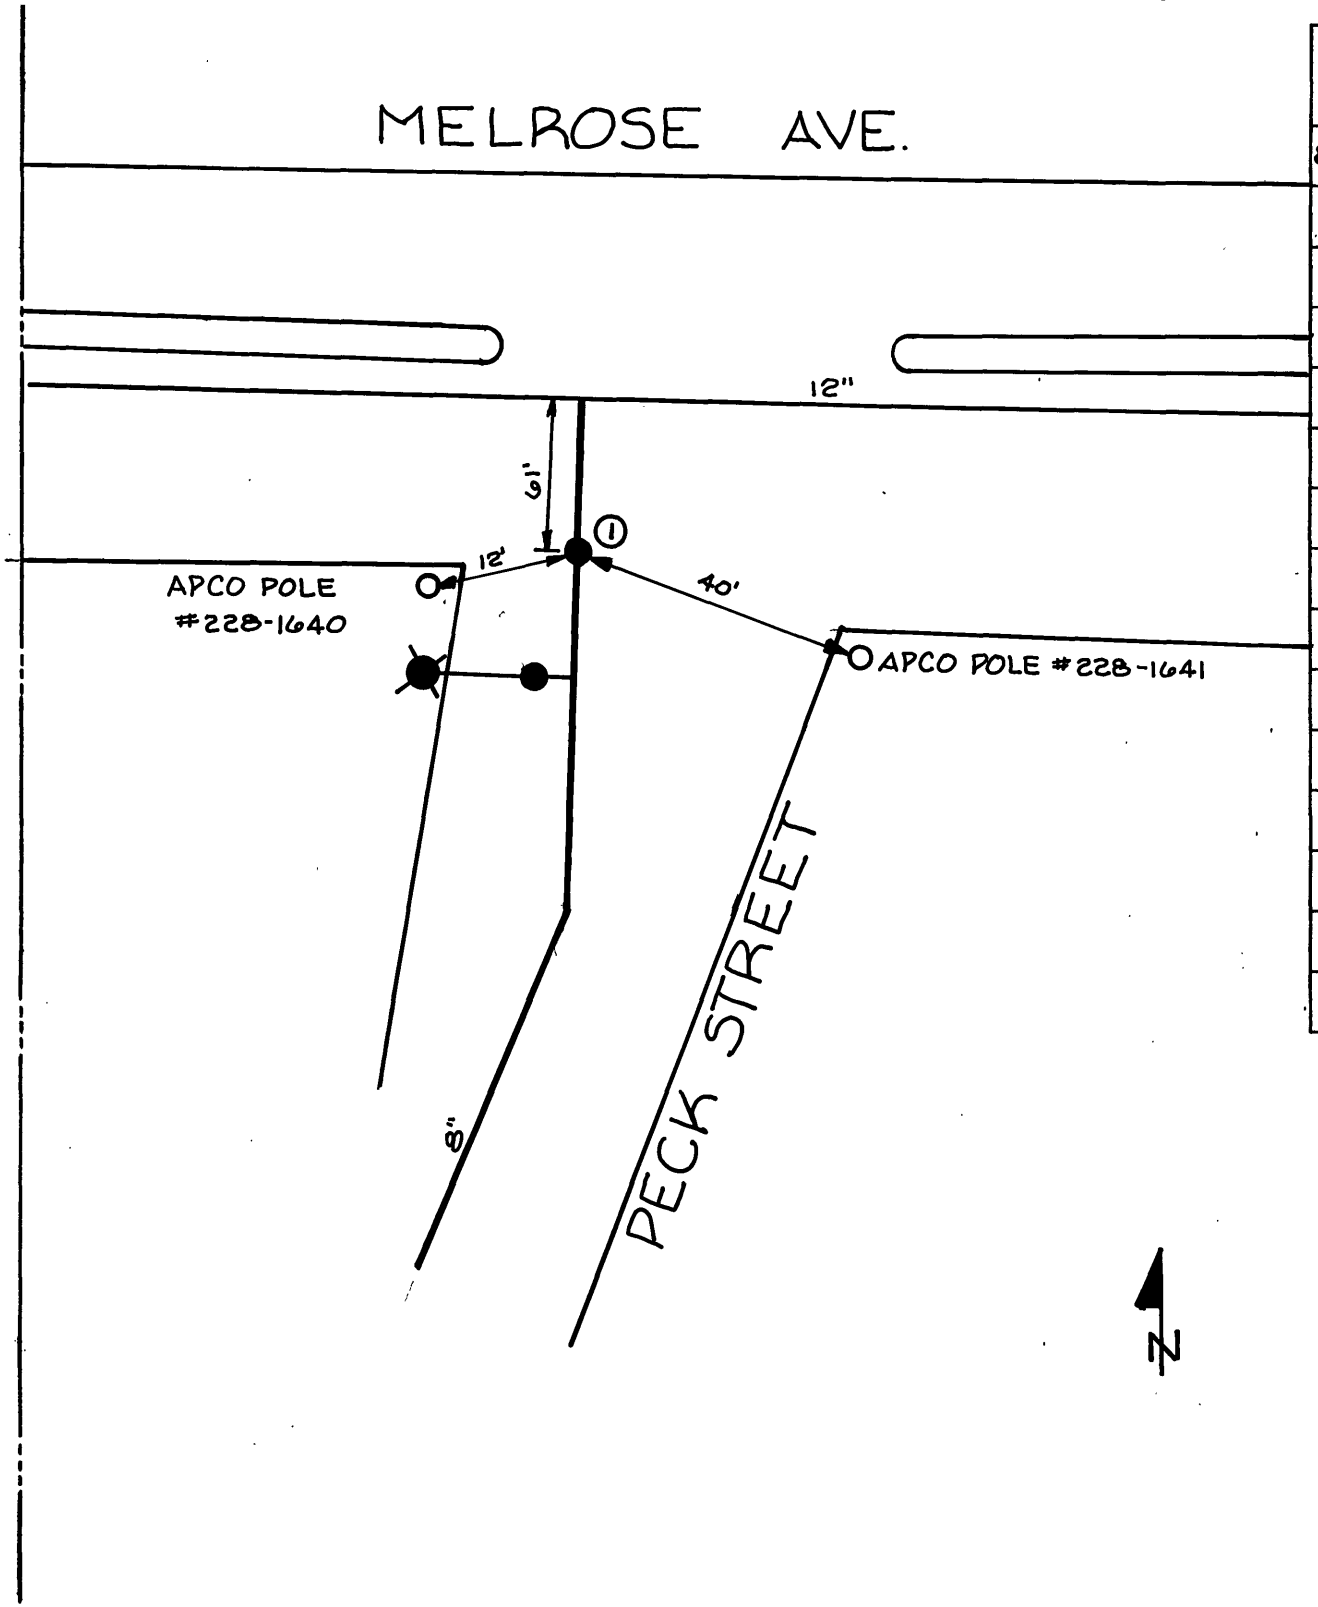

DATE	NO.	SIZE	MAKE	OPEN	TURNS
8-81	1	8"	MUELLER	R	

CITY OF ROANOKE—WATER DEP'T

VALVE DIAGRAM

MELROSE AVE. AND

PECK ST.

N.W.

SEC. MAP 609

DATE 8-81 PAGE NO.