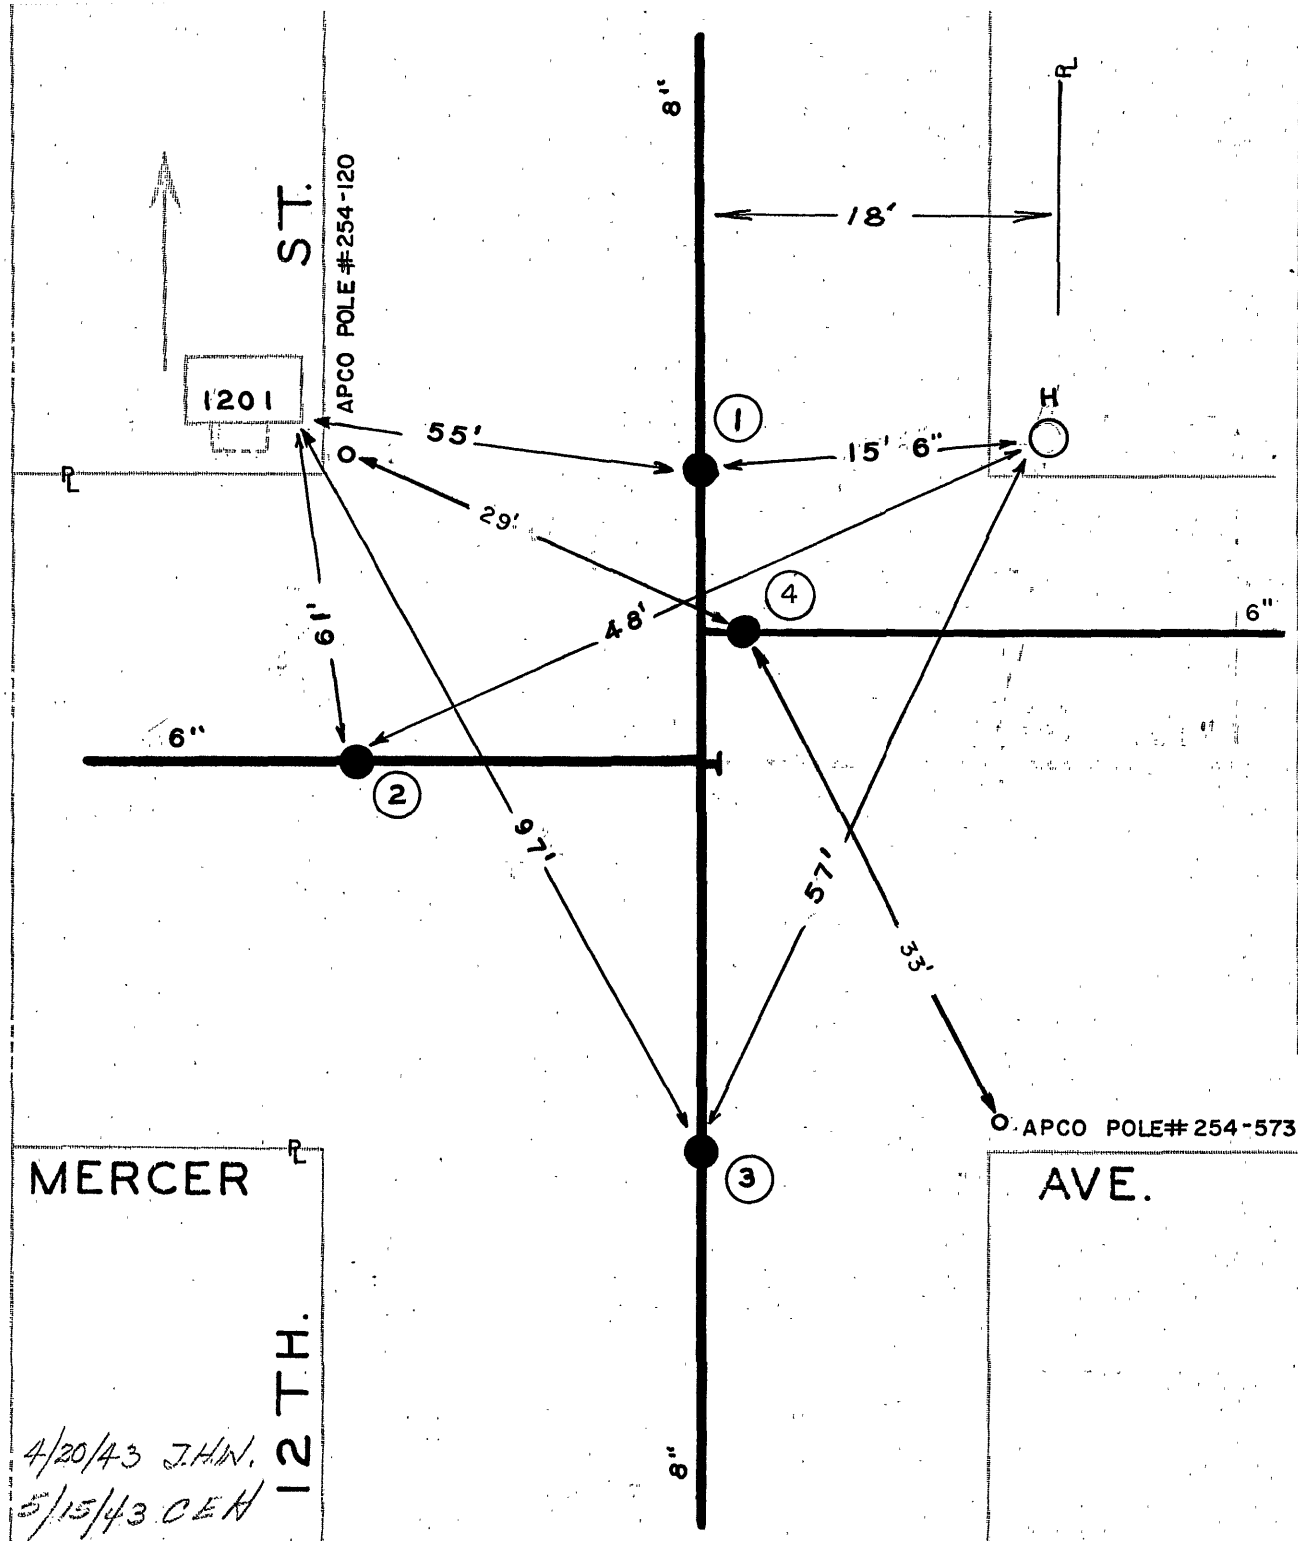

DATE	NO.	SIZE	MAKE	OPEN	TURNS
1939	1	8"		R	27
1939	2	6"		R	20 1/2
1939	3	8"		R	27
8-92	4	6"	MUELLER	R	
	1	0	NPL		
	2	0	WPL		
	3	0	SPL		

4/20/43 J.H.W.
5/15/43 C.E.N
5/93 NP

CITY OF ROANOKE—WATER DEPT.
VALVE DIAGRAM
MERCER AVE. & 12TH. ST. N.W.
SEC. MAP 223
DATE
PAGE NO. NW 167