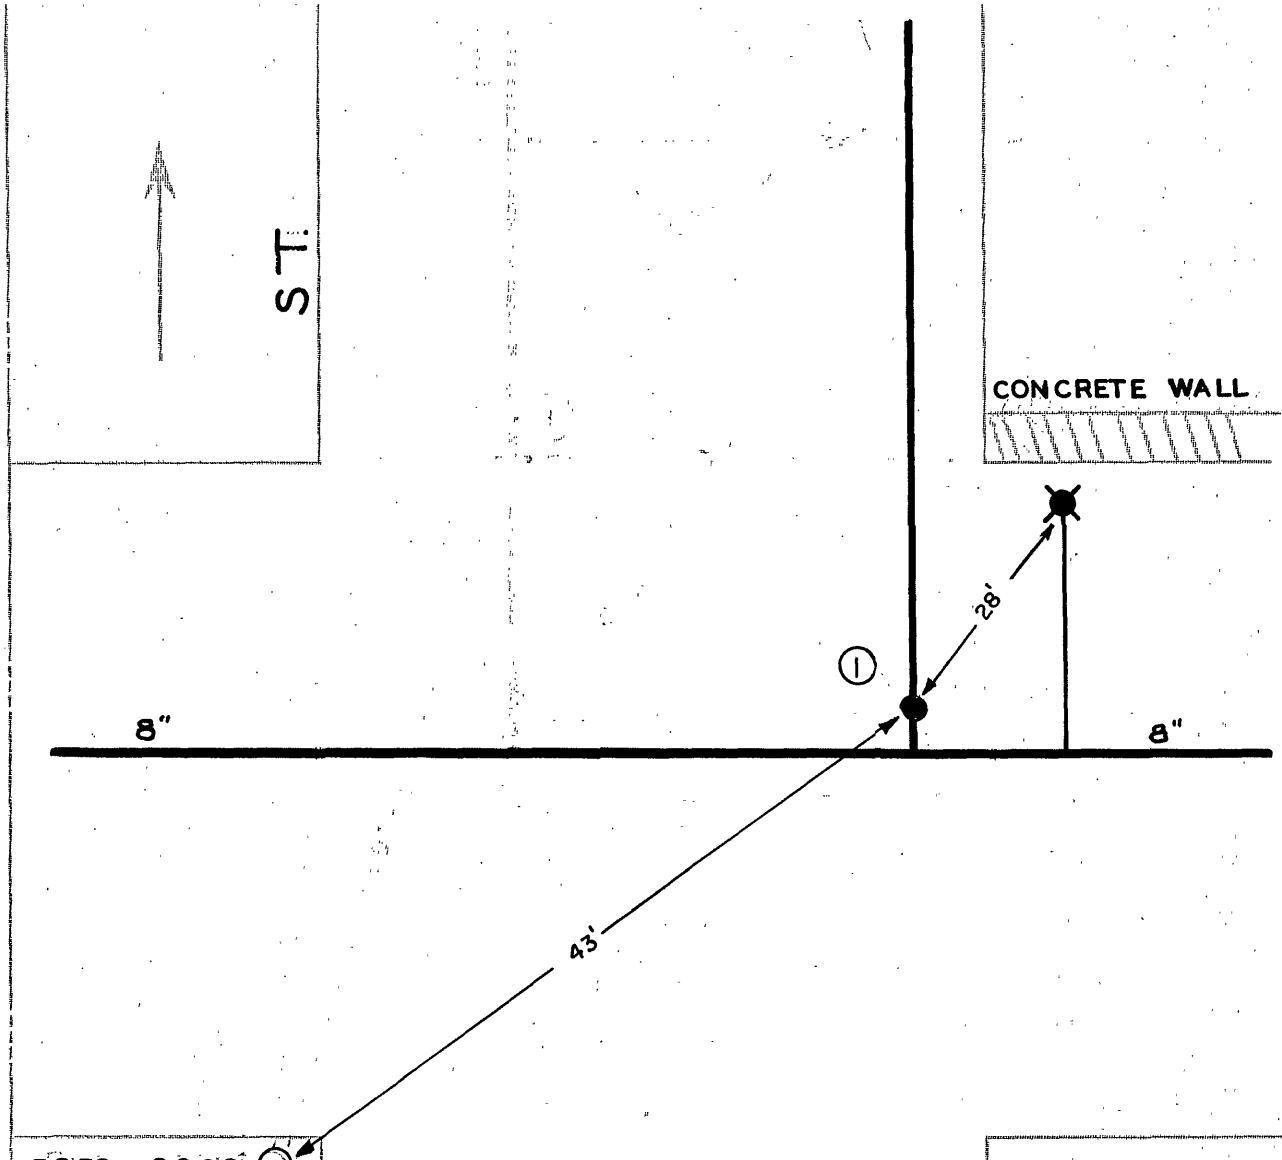

DATE	NO.	SIZE	MAKE	OPEN	TURNS
1993	1	6"	MUELLER	R	

4/27/43 J.H.W.
5/15/43 C.E.H.
4/94 NP

CITY OF ROANOKE—WATER DEP'T
VALVE DIAGRAM
MOORMAN ROAD & 20TH. ST. N.W.
SEC. MAP 232
DATE
PAGE NO. NW 193