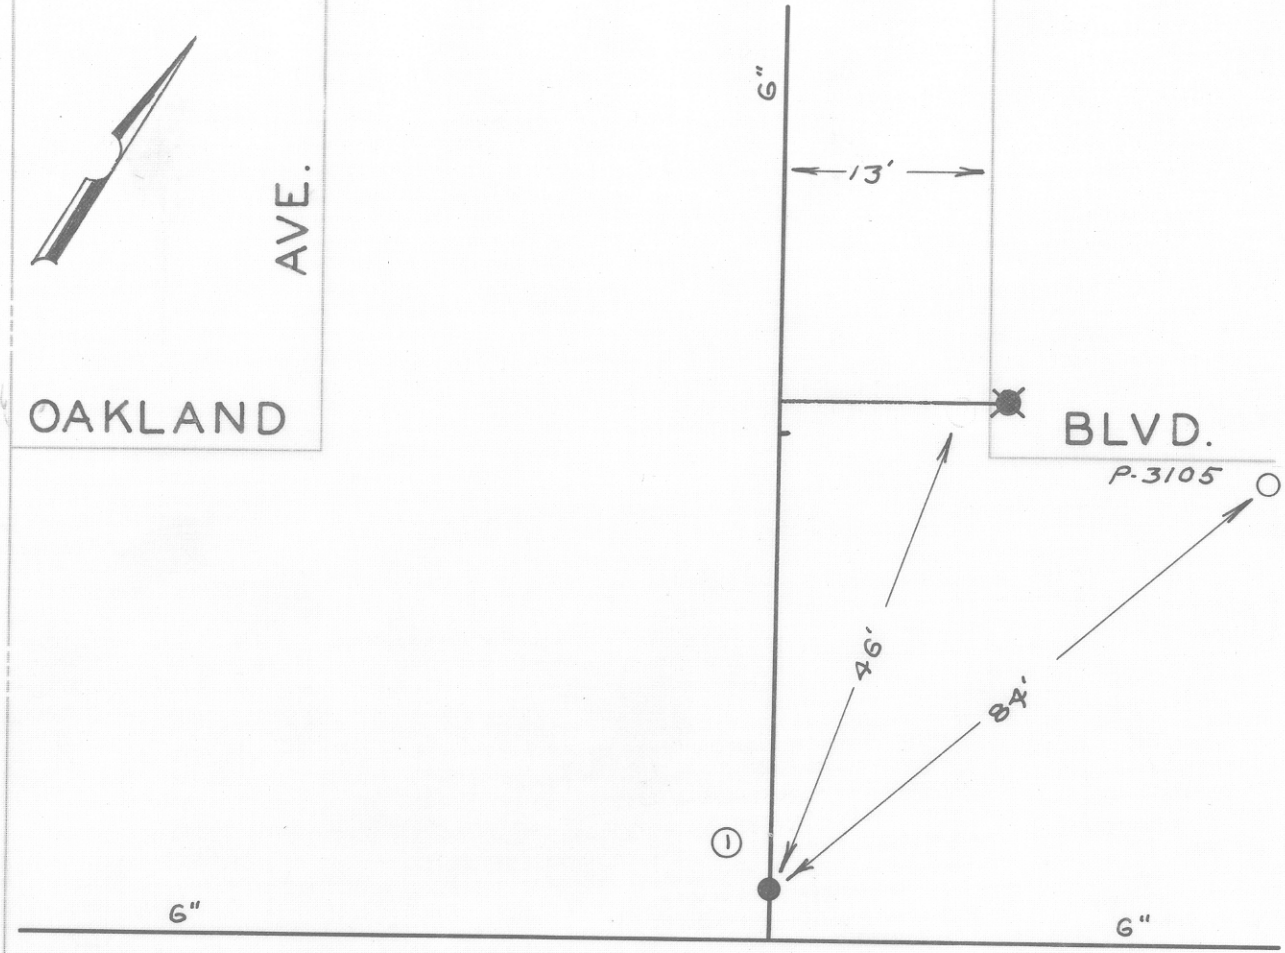

DATE	NO.	SIZE	MAKE	OPEN	TURNS
1952	1	6"	Tapping		
	1	34-S	NPL		

SUNRISE

2/2001 JH

CITY OF ROANOKE—WATER DEP'T

VALVE DIAGRAM

OAKLAND BLVD. &

SUNRISE AVE.

SEC. MAP 208, 215 N.W.

DATE PAGE NO.