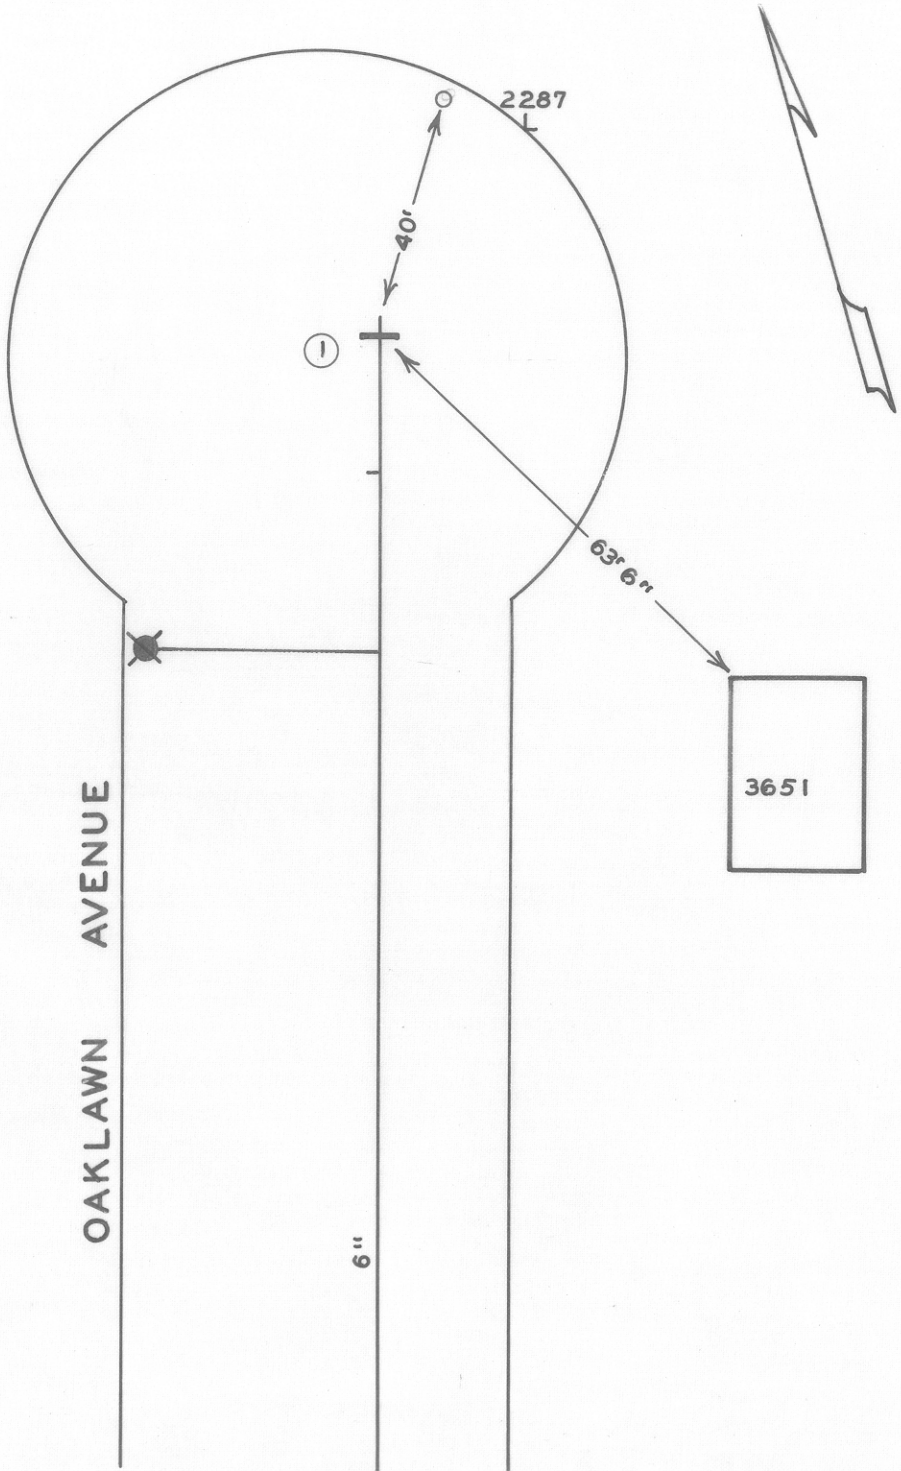

DATE	NO.	SIZE	MAKE	OPEN	TURNS
6-65	1	2	MISC	L	

2/2001 JH

CITY OF ROANOKE — WATER DEPT.

VALVE DIAGRAM

OAKLAWN AVENUE N.W.

SEC. MAP 218 N. W.

DATE PAGE NO.