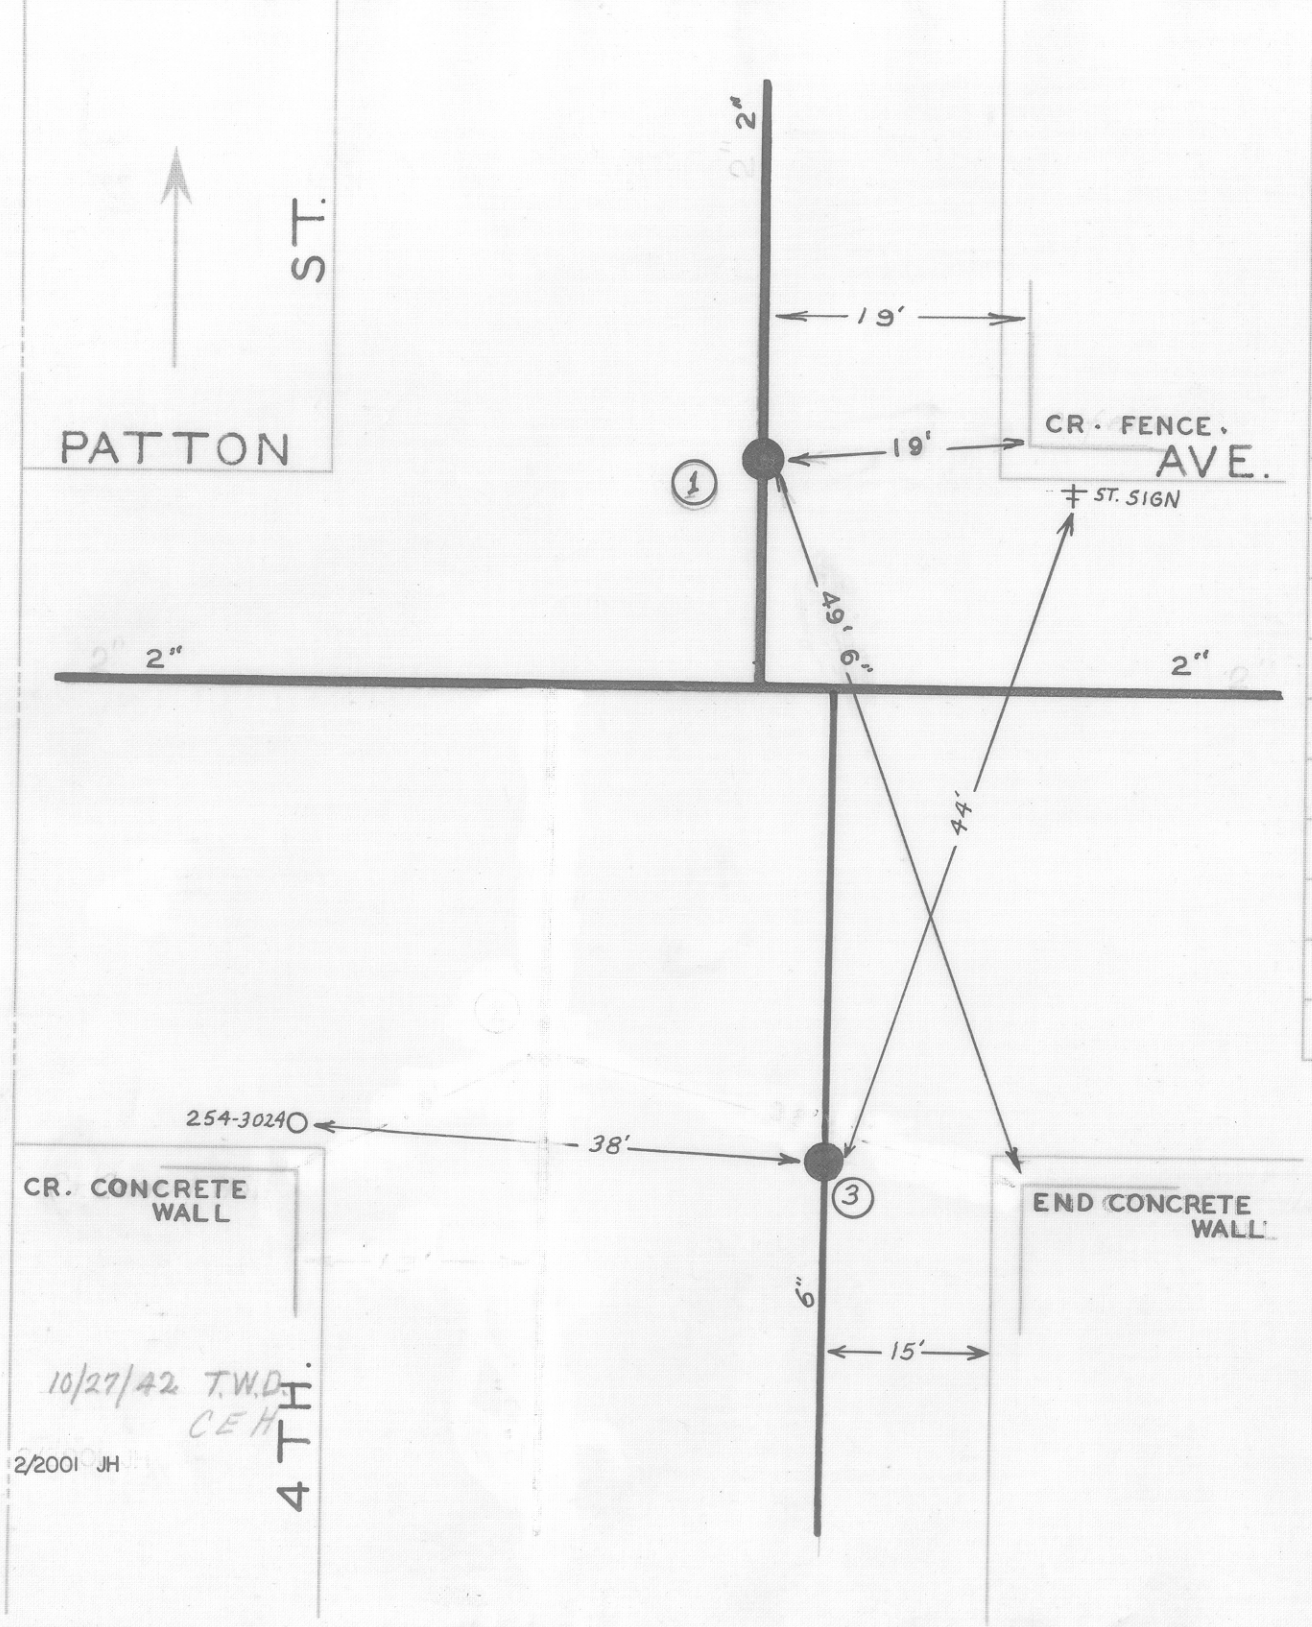

DATE	NO.	SIZE	MAKE	OPEN	TURNS
1930	1	2"		R	9
~~1924~~	~~2~~	~~2"~~		~~R~~	~~7~~
1969	3	6"	MUELLER	R	
	1	3'-S	NPL		
	2	8'-N	SPL		
	3	0	SPL		

CITY OF ROANOKE—WATER DEP'T

VALVE DIAGRAM

PATTON AVE & 4TH

4TH STREET

SEC. MAP 201 N.W.

DATE PAGE NO. NW. 27