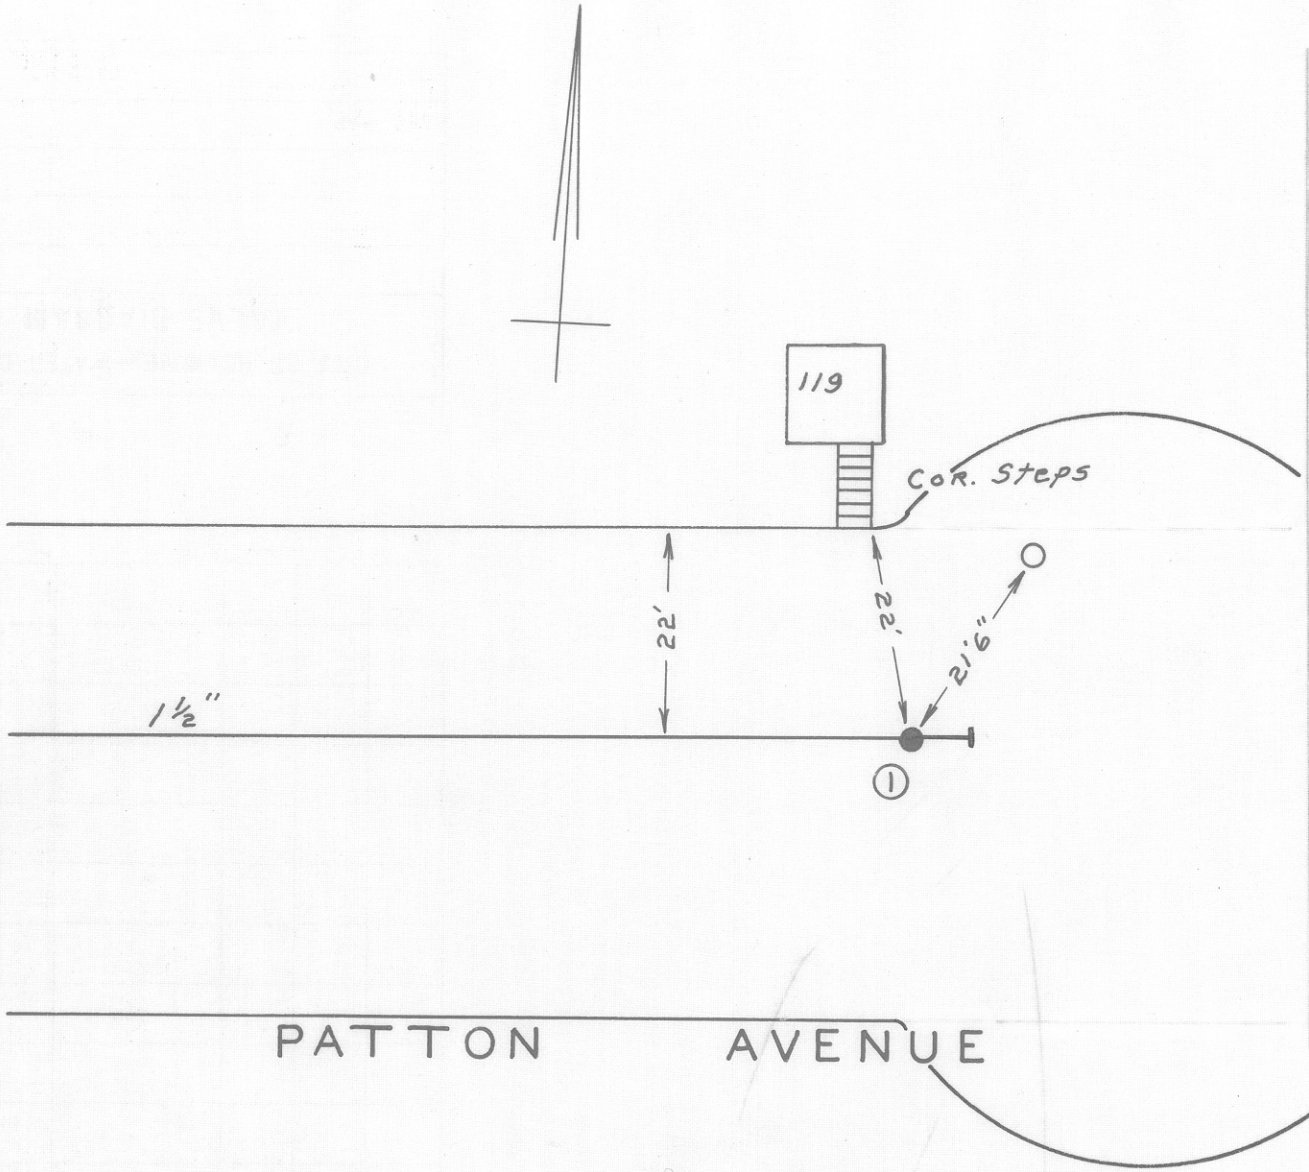

DATE	NO.	SIZE	MAKE	OPEN	TURNS
1936	1	1½"	MISC.		

CITY OF ROANOKE — WATER DEPT.

VALVE DIAGRAM

PATTON AVE. N.W.

E. OF 2ND. STREET

SEC. MAP 201 N.W.

DATE PAGE NO.

2/2001 JH

IMPERIAL TRACING CLOTH
K & E CO., N.Y.