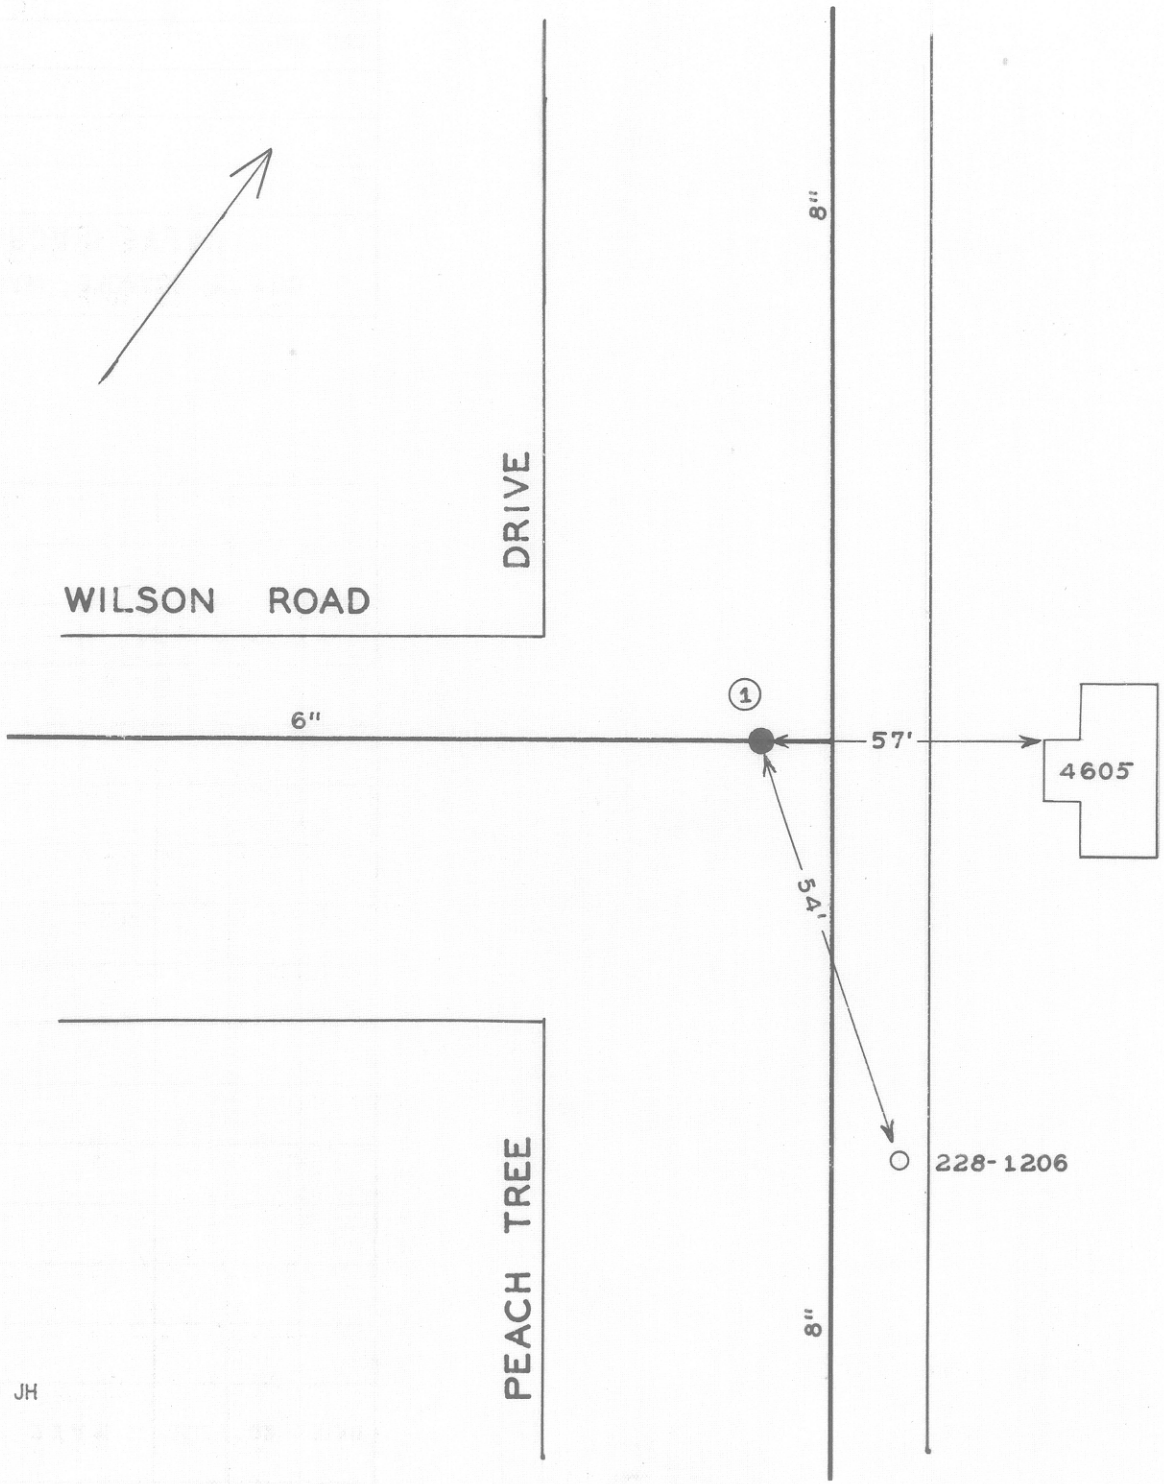

DATE	NO.	SIZE	MAKE	OPEN	TURNS
'55	1	6"			

2/2001 JH

CITY OF ROANOKE — WATER DEPT.

VALVE DIAGRAM

PEACH TREE DRIVE &

WILSON ROAD N.W.

SEC. MAP 612 N.W.

DATE PAGE NO.

"IMPERIAL" TRACING CLOTH
K & E CO., N. Y.