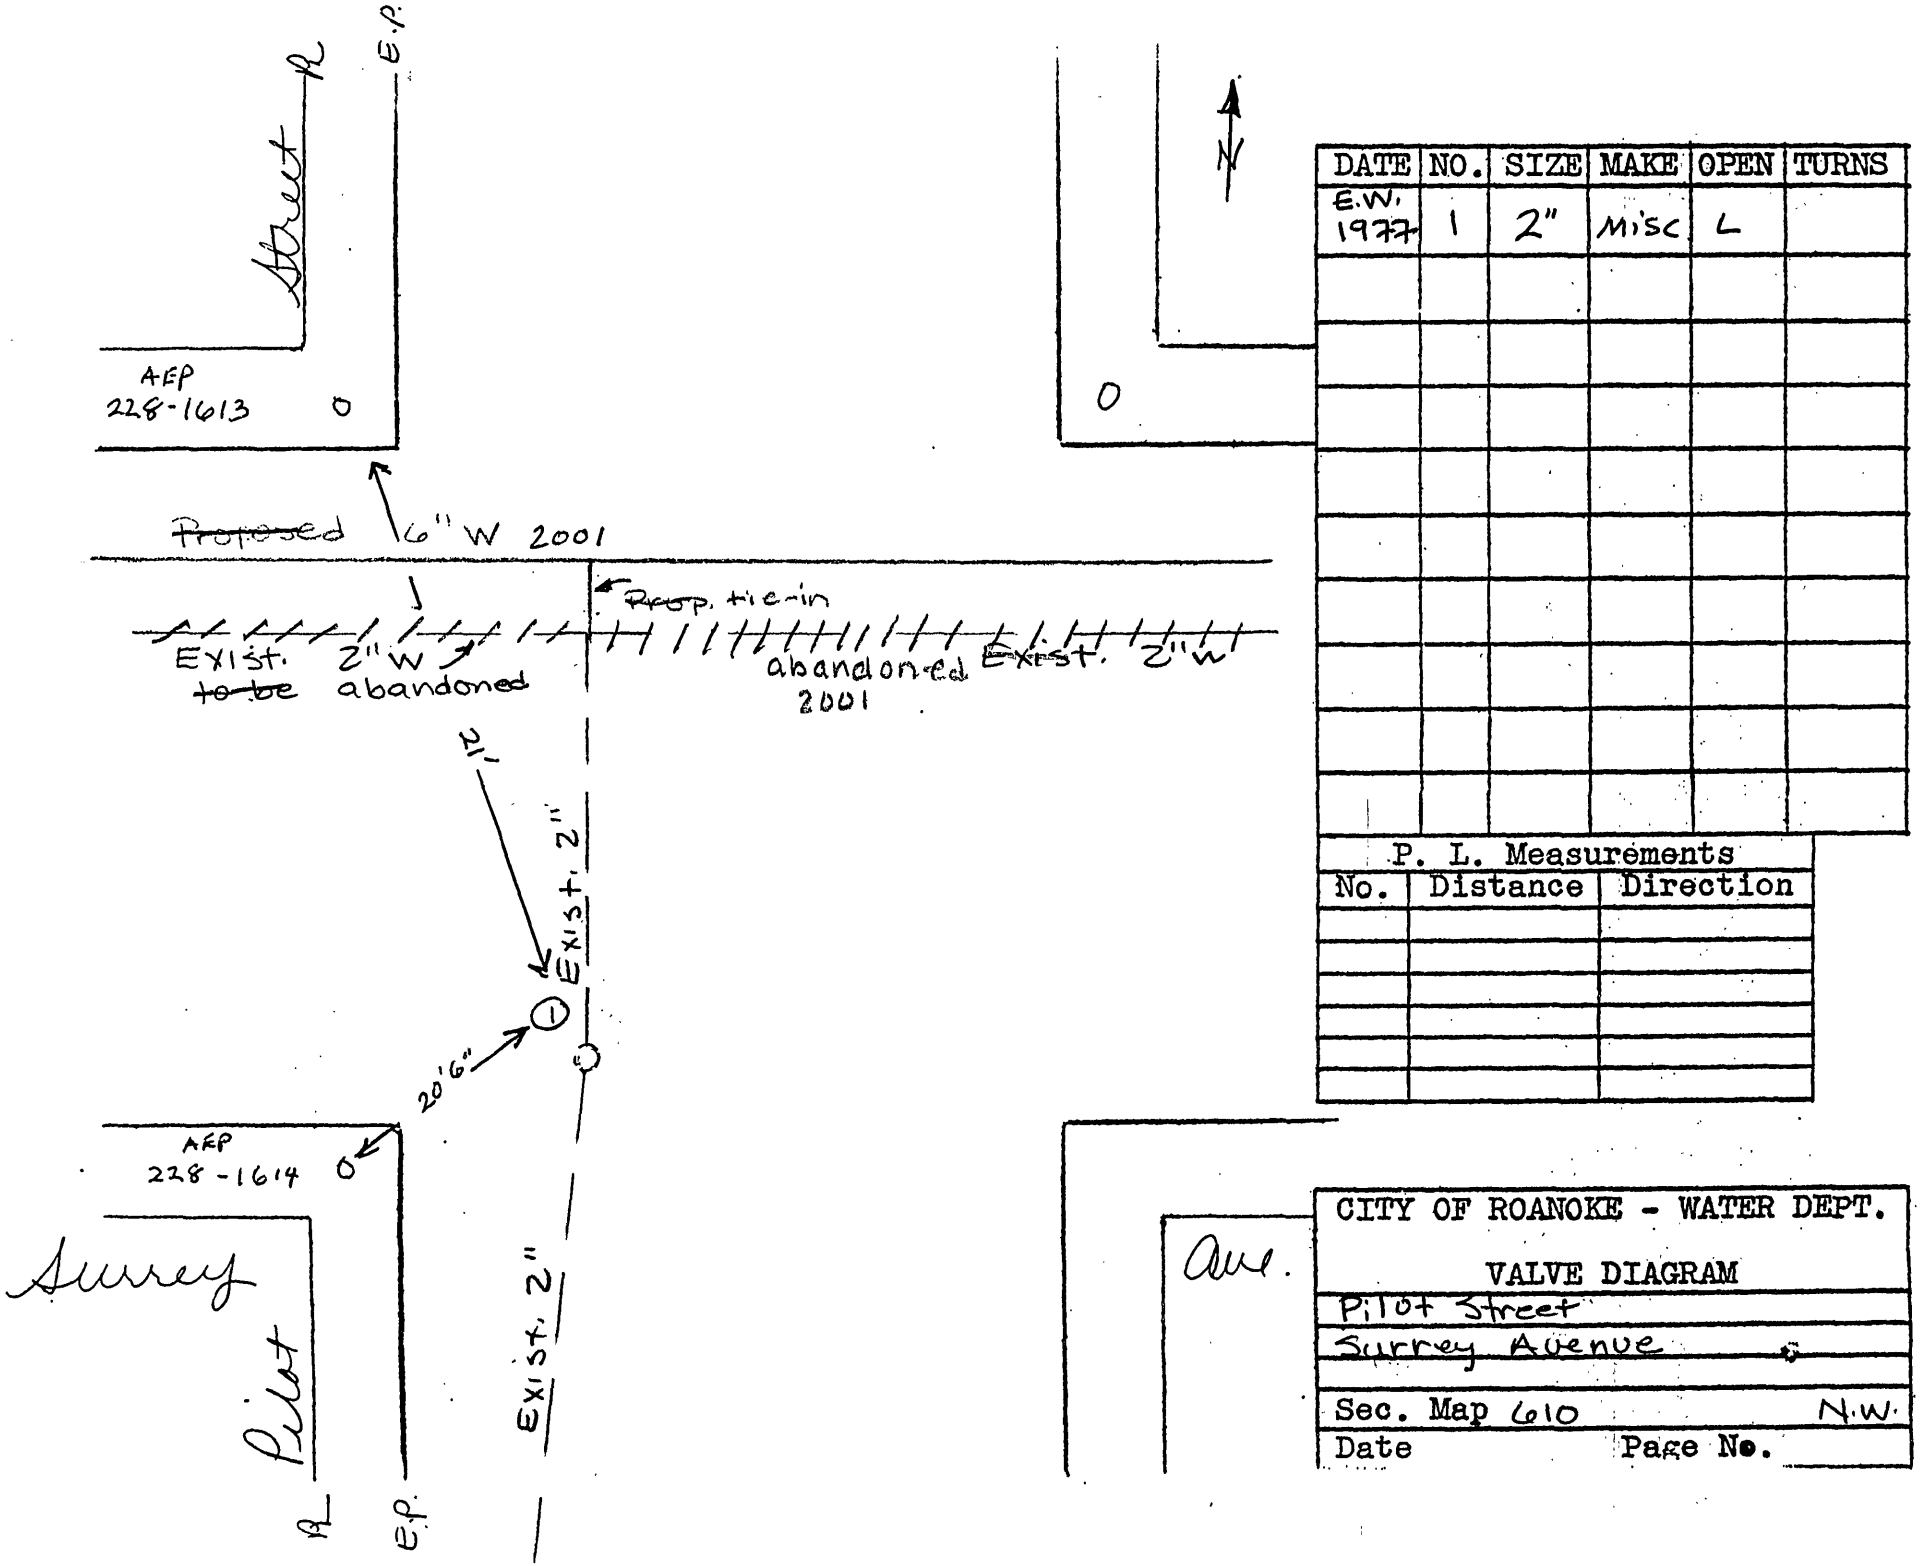

DATE	NO.	SIZE	MAKE	OPEN	TURNS
E.W. 1977	1	2"	Misc	L	

P. L. Measurements		
No.	Distance	Direction

CITY OF ROANOKE - WATER DEPT.

VALVE DIAGRAM

Pilot Street

Surrey Avenue

Sec. Map 610 N.W.

Date Page No.