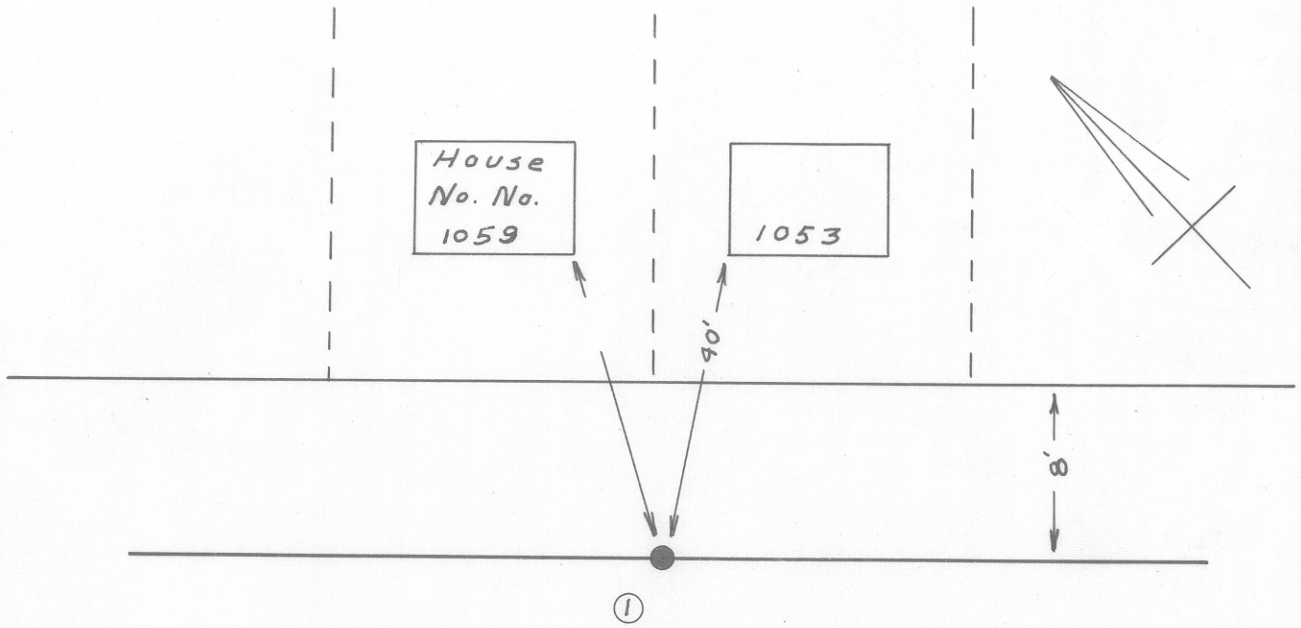

PLEASANT VIEW AVE.

DATE	NO.	SIZE	MAKE	OPEN	TURNS
'27	1	2"	DARLING	R	7

CITY OF ROANOKE — WATER DEPT.

VALVE DIAGRAM

PLEASANT VIEW AVE.

BET. 10TH. ST. & COURT

STREET N. W.

SEC. MAP 214

DATE PAGE NO.

"IMPERIAL" TRACING CLOTH
K & E CO., N. Y.