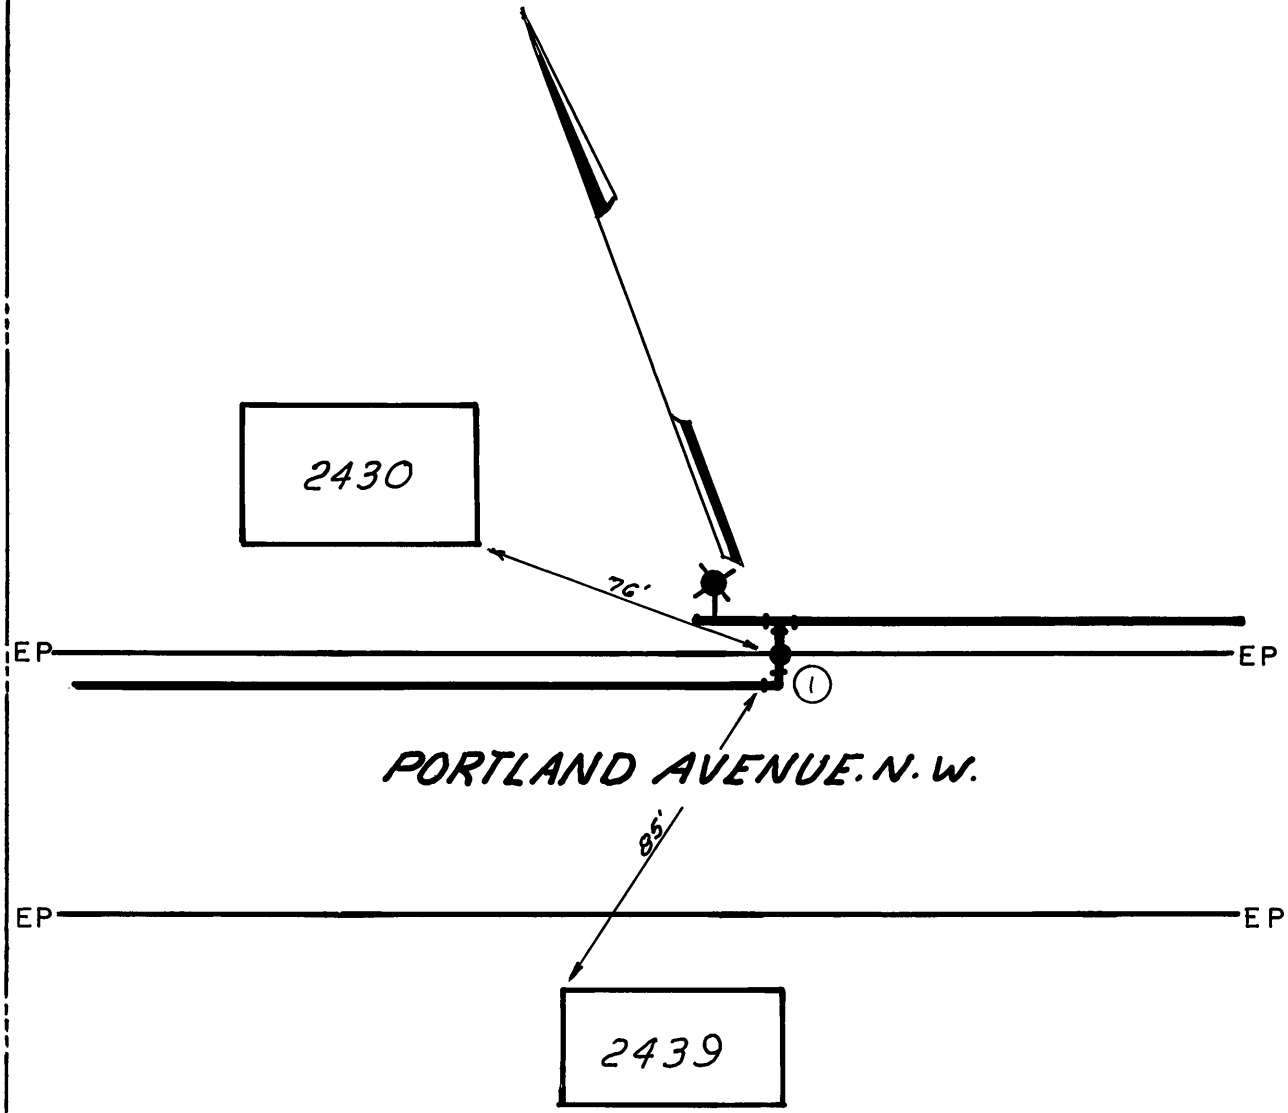

DATE	NO.	SIZE	MAKE	OPEN	TURNS
12/84	1	4"		R	

1/2001 JH

CITY OF ROANOKE—WATER DEP'T

VALVE DIAGRAM

PORTLAND AVENUE

SEC. MAP 641 N.W.

DATE 4-8-85 PAGE NO.