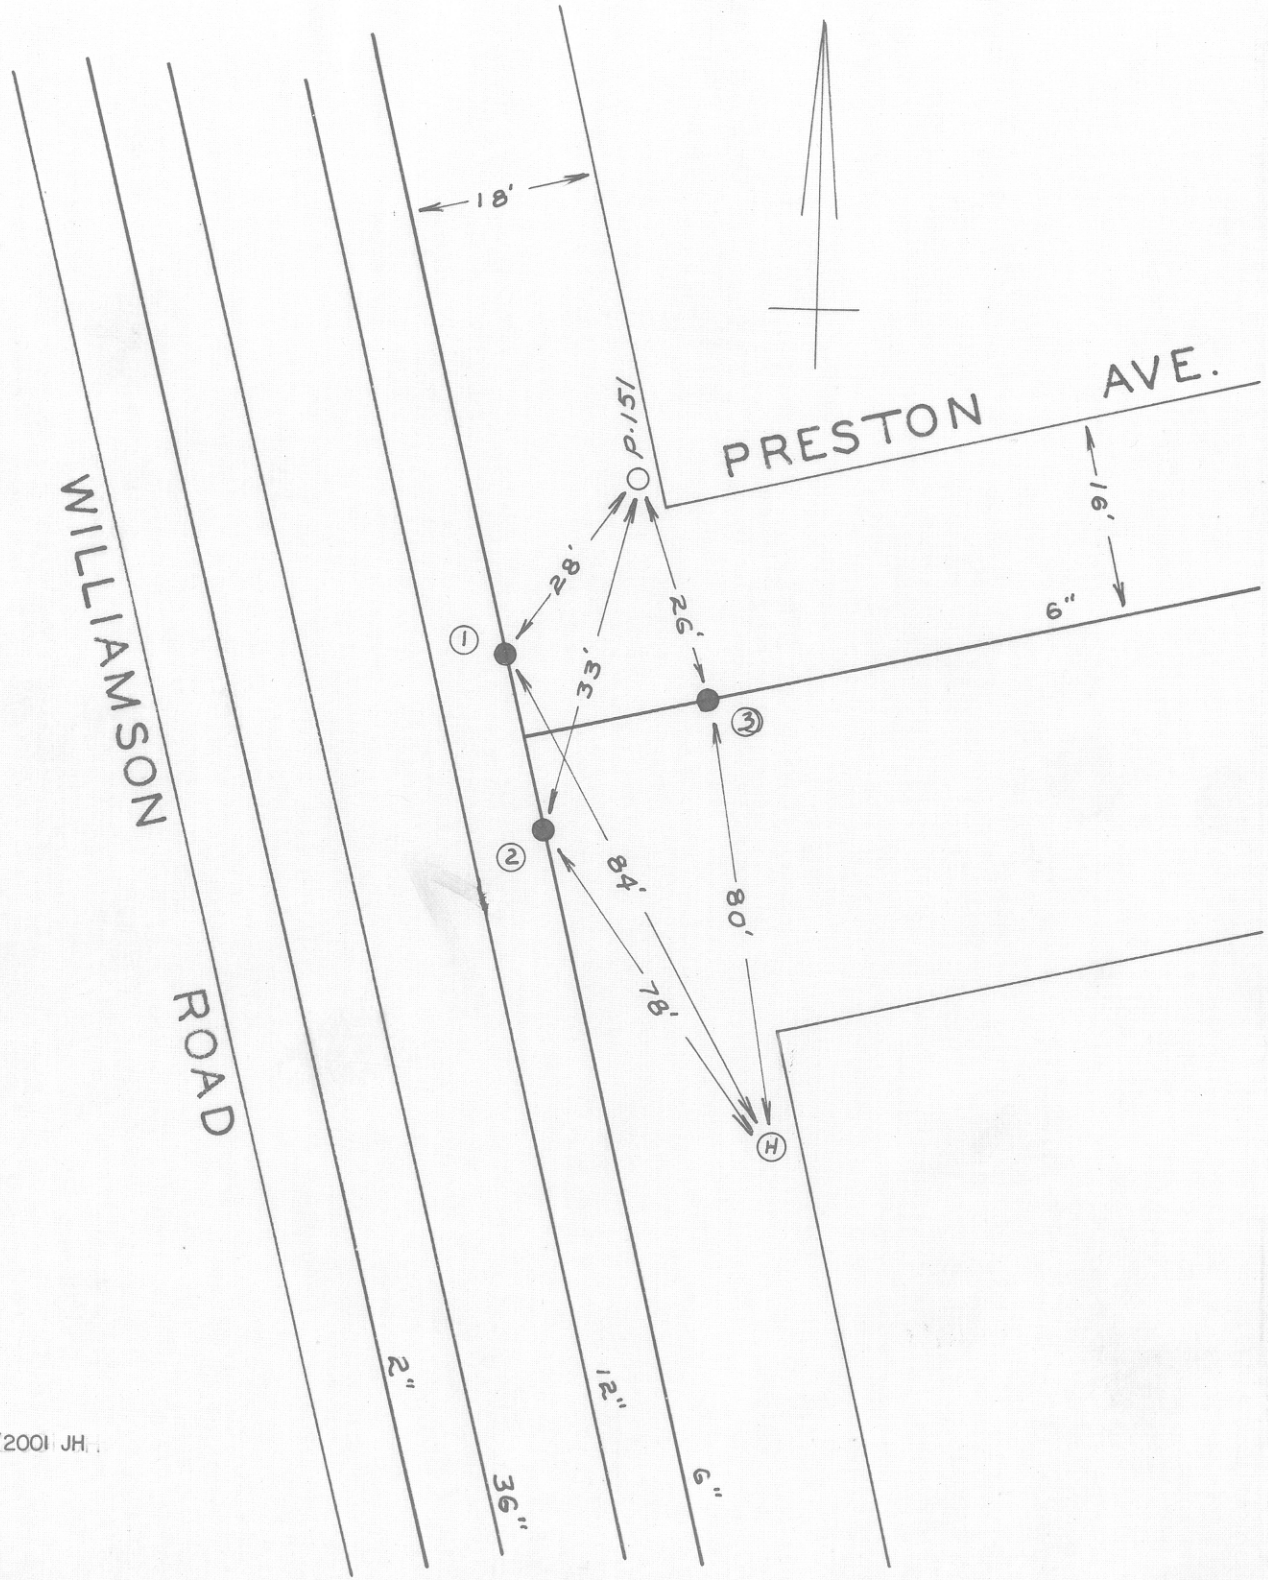

DATE	NO.	SIZE	MAKE	OPEN	TURNS
1953	1	6"	MUELLER	R	20
1951	2	6"	MUELLER	R	20
1951	3	6"	MUELLER	R	20
	1	16'-S	NPL		
	2	35'-N	SPL		
	3	0	EPL		

2/2001 JH

CITY OF ROANOKE — WATER DEPT.

VALVE DIAGRAM

PRESTON AVE. &

WILLIAMSON RD.

SEC. MAP 210 N.W.

DATE PAGE NO.

"IMPERIAL" TRACING CLOTH
K & E CO., N. Y.