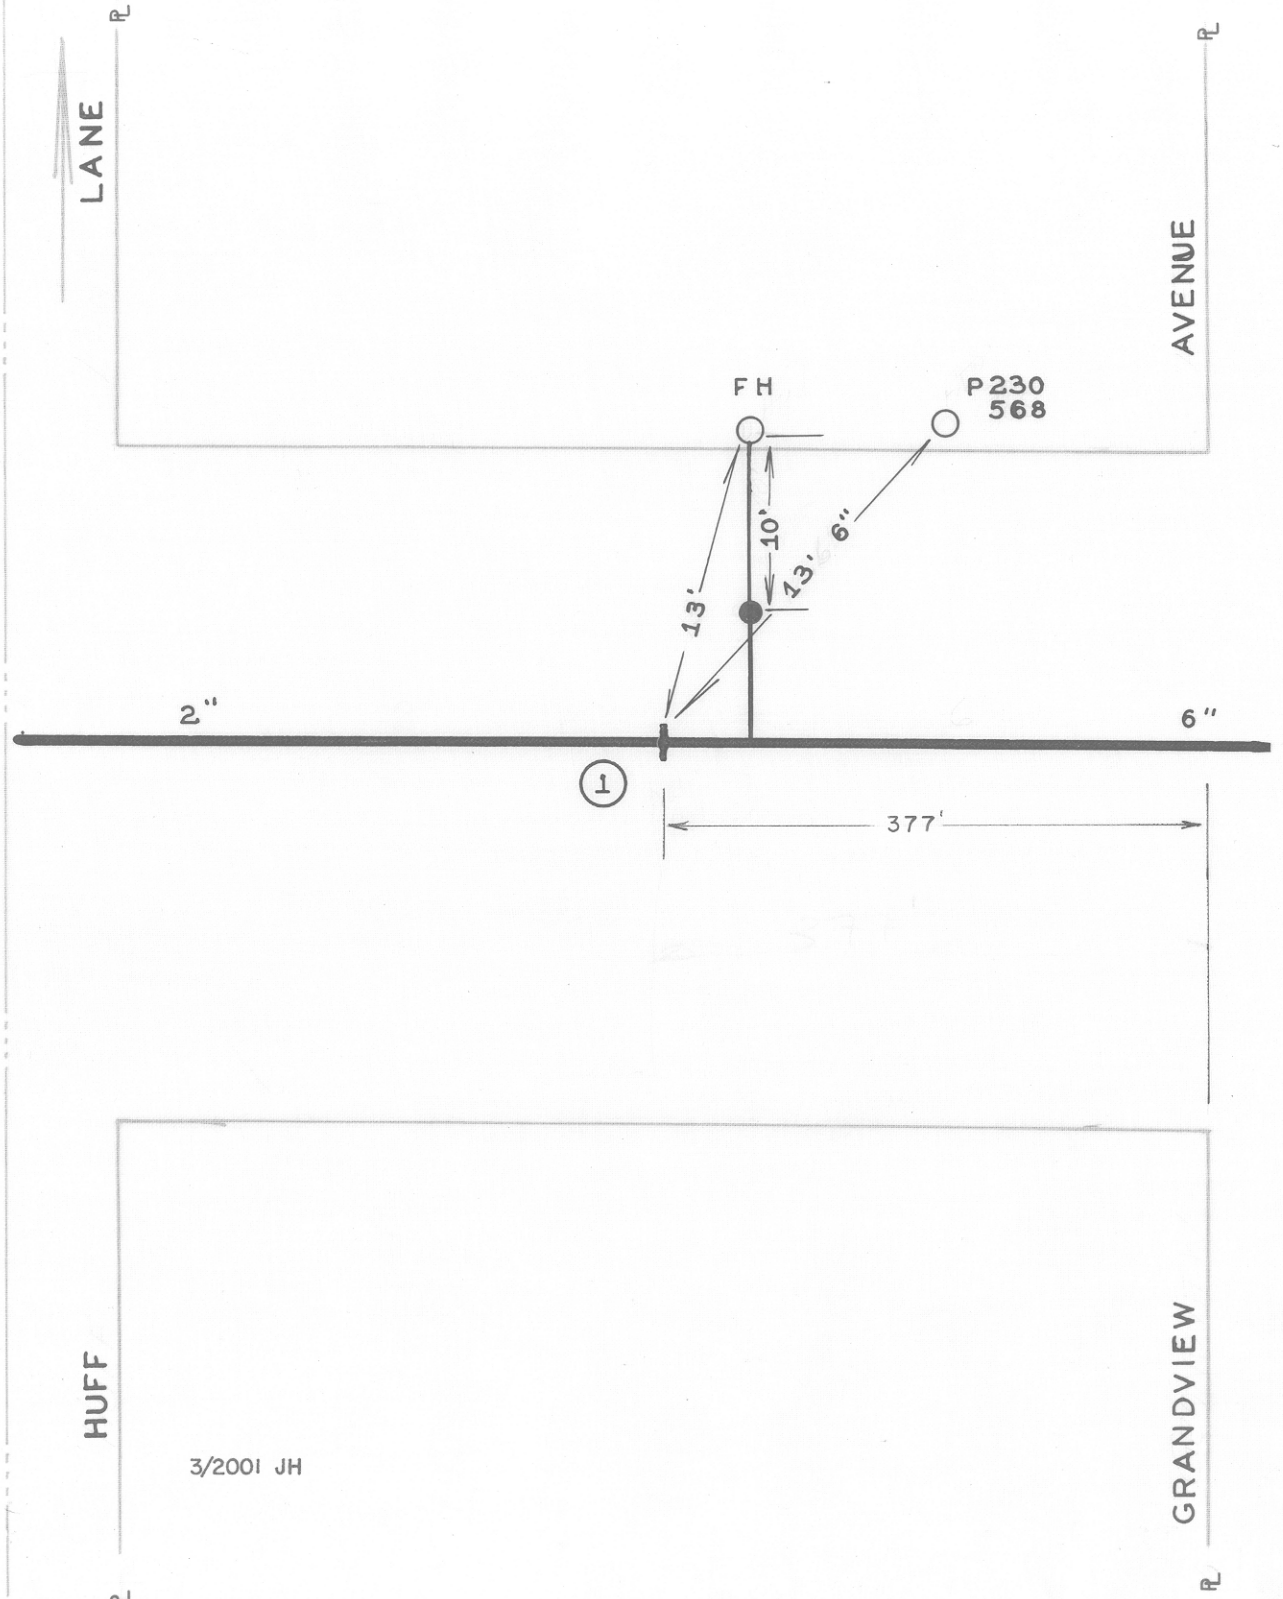

DATE	NO.	SIZE	MAKE	OPEN	TURNS
W R 1951	1	2"			
	1	377	W WPL		

CITY OF ROANOKE — WATER DEPT.

VALVE DIAGRAM

RAVENWOOD AVENUE BETWEEN GRANDVIEW AVENUE & HUFF LANE

SEC. MAP 226 N.W.

DATE W. R. PAGE NO. NW. 385

"IMPERIAL" TRACING CLOTH
K & E CO., N. Y.