DATE	NO.	SIZE	MAKE	OPEN	TURNS
11-81	1	2"	BLOW-OFF		
11-81	2	8"	MUELLER		
1981	3	8"			
1981	4	8"			

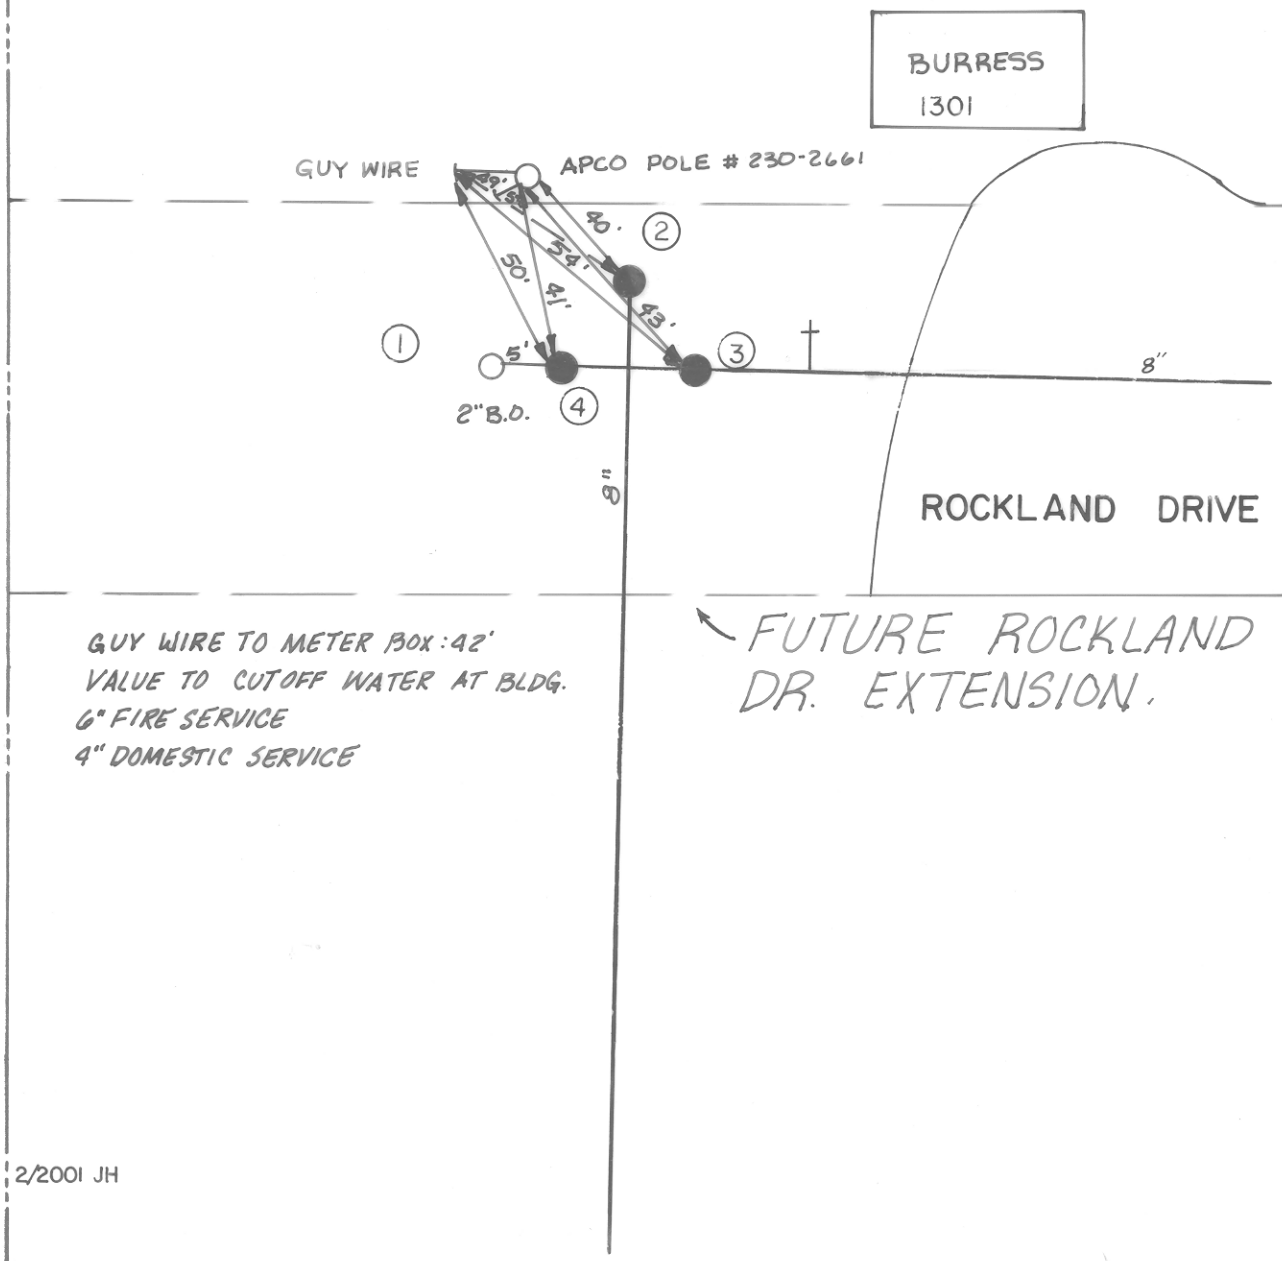

GUY WIRE TO METER BOX: 42'
VALVE TO CUTOFF WATER AT BLDG.
6" FIRE SERVICE
4" DOMESTIC SERVICE

2/2001 JH

CITY OF ROANOKE — WATER DEP'T
VALVE DIAGRAM

ROCKLAND DR.

SEC. MAP 213, N.W.

DATE ≈1982 PAGE NO.