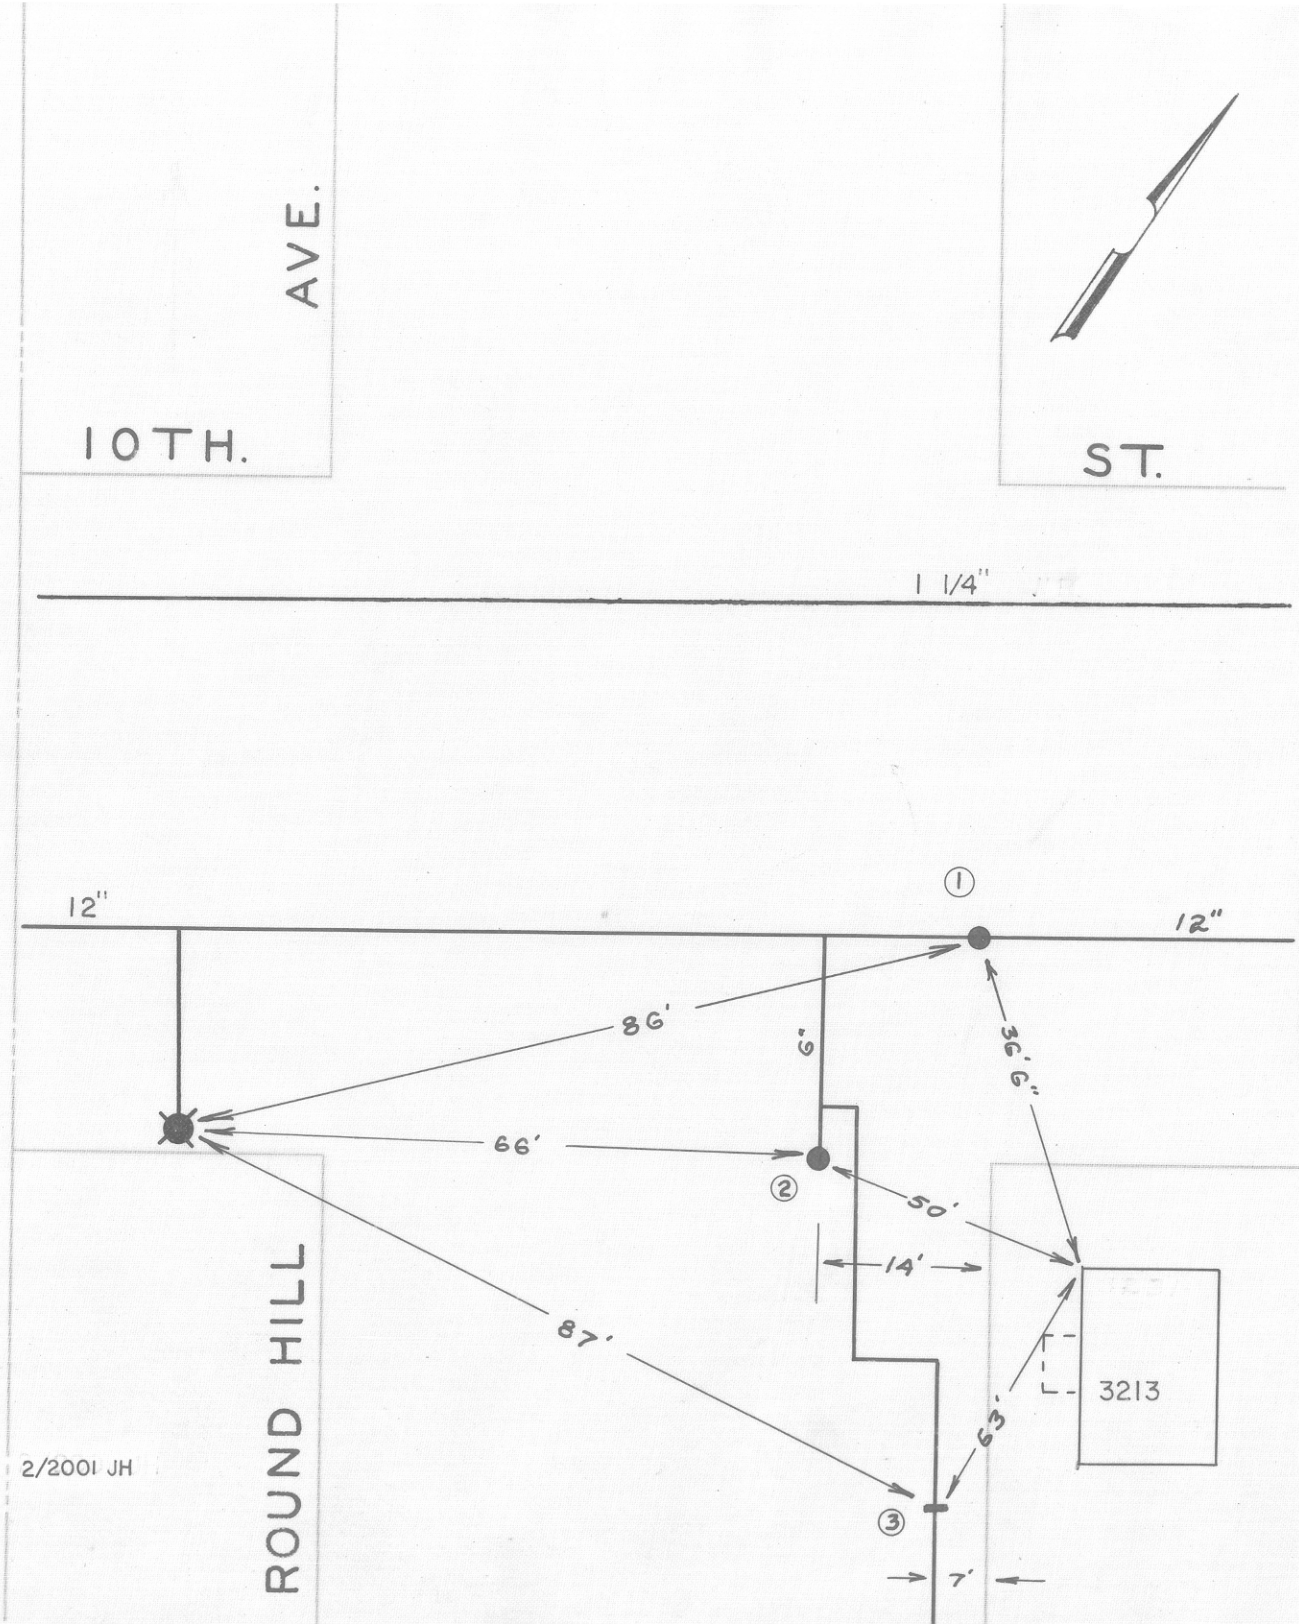

DATE	NO.	SIZE	MAKE	OPEN	TURNS
1953	1	12"	MUELLER	R	38
1953	2	6"	MUELLER	R	20
1951	3	2"			
	1	0	EPL		
	2	0	SPL		
	3	46'-S	SPL		

CITY OF ROANOKE—WATER DEP'T

VALVE DIAGRAM

ROUND HILL AVE. &

10TH. STREET N.W.

SEC. MAP 208 , 207 N.W.

DATE PAGE NO.