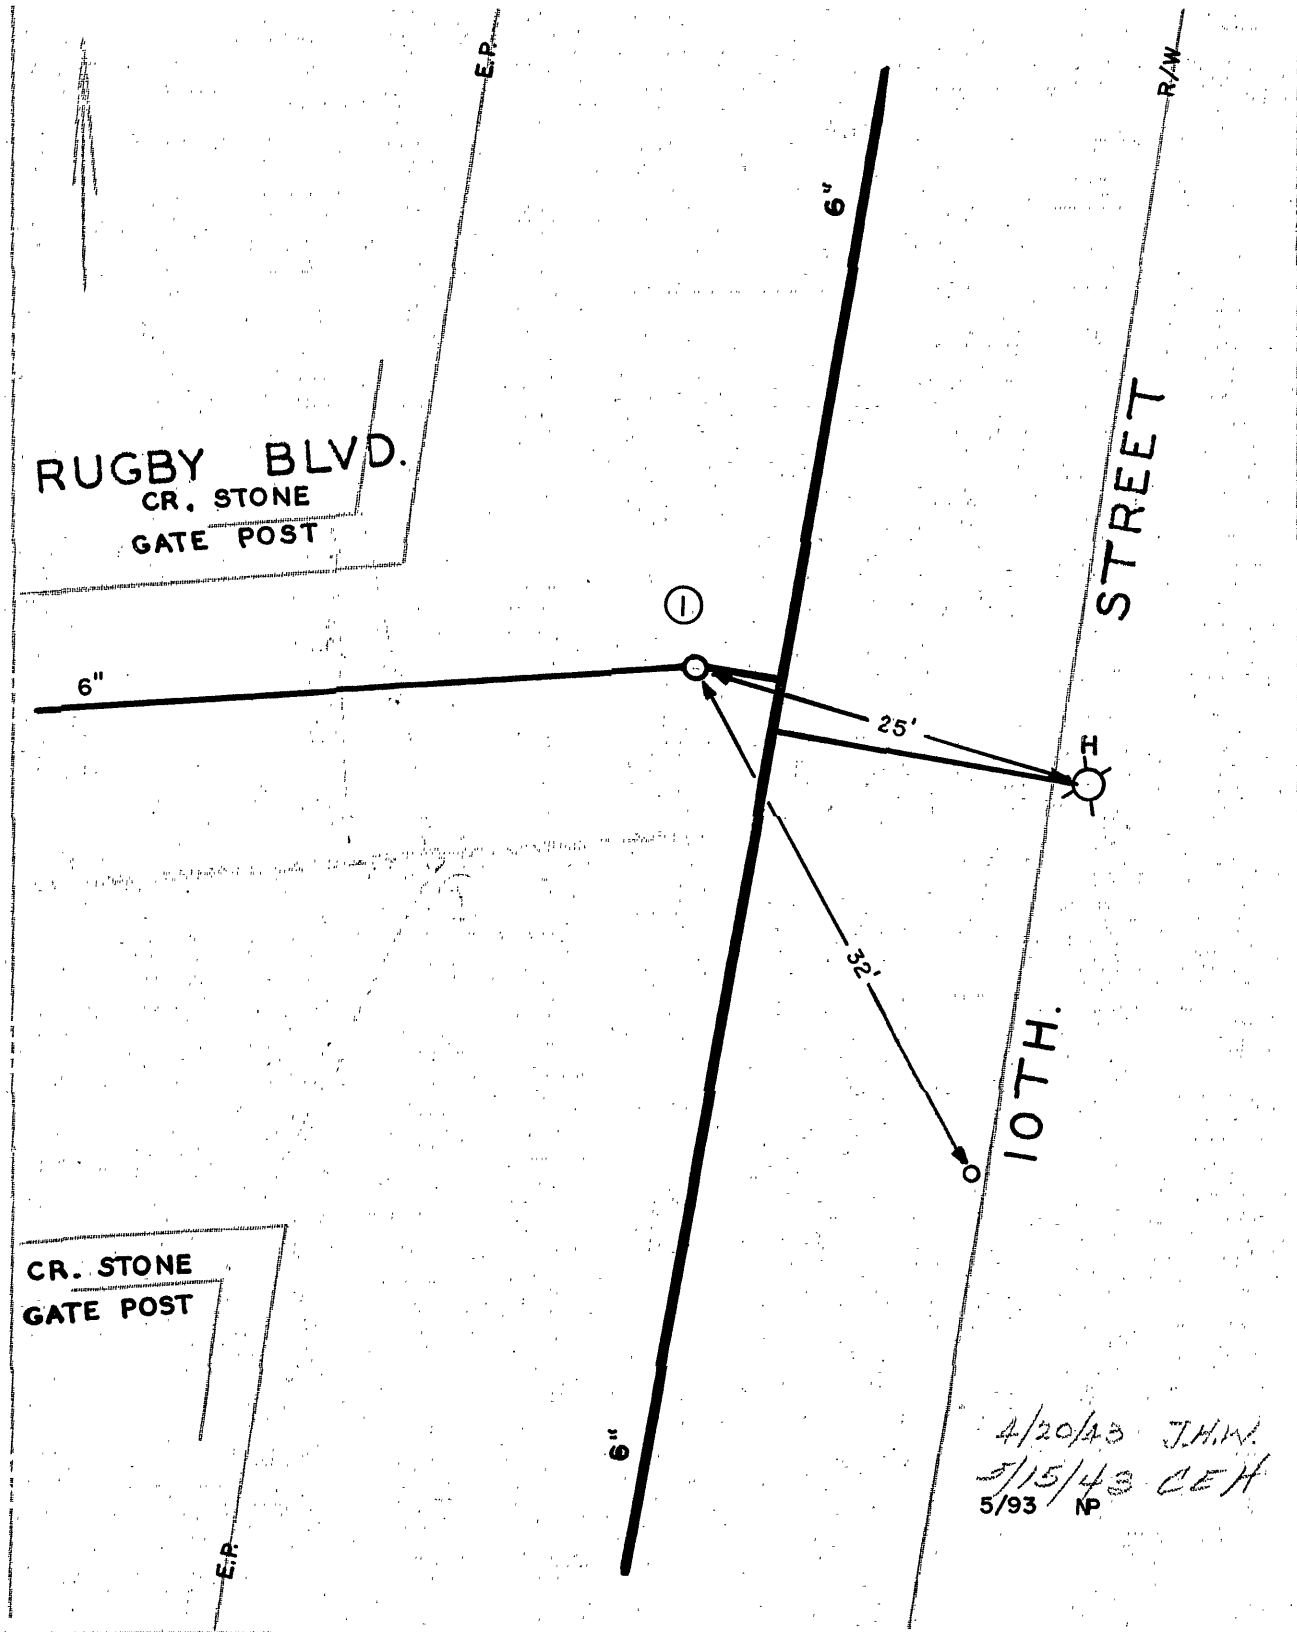

DATE	NO.	SIZE	MAKE	OPEN	TURNS
9-92	1	6"	MUELLER	R	19

4/20/43 J.H.W.
5/15/43 C.E.H.
5/93 NP

CITY OF ROANOKE—WATER DEP'T
VALVE DIAGRAM
RUGBY BLVD. & 10TH. ST. N.W.

SEC. MAP 223

DATE

PAGE NO. NW.169