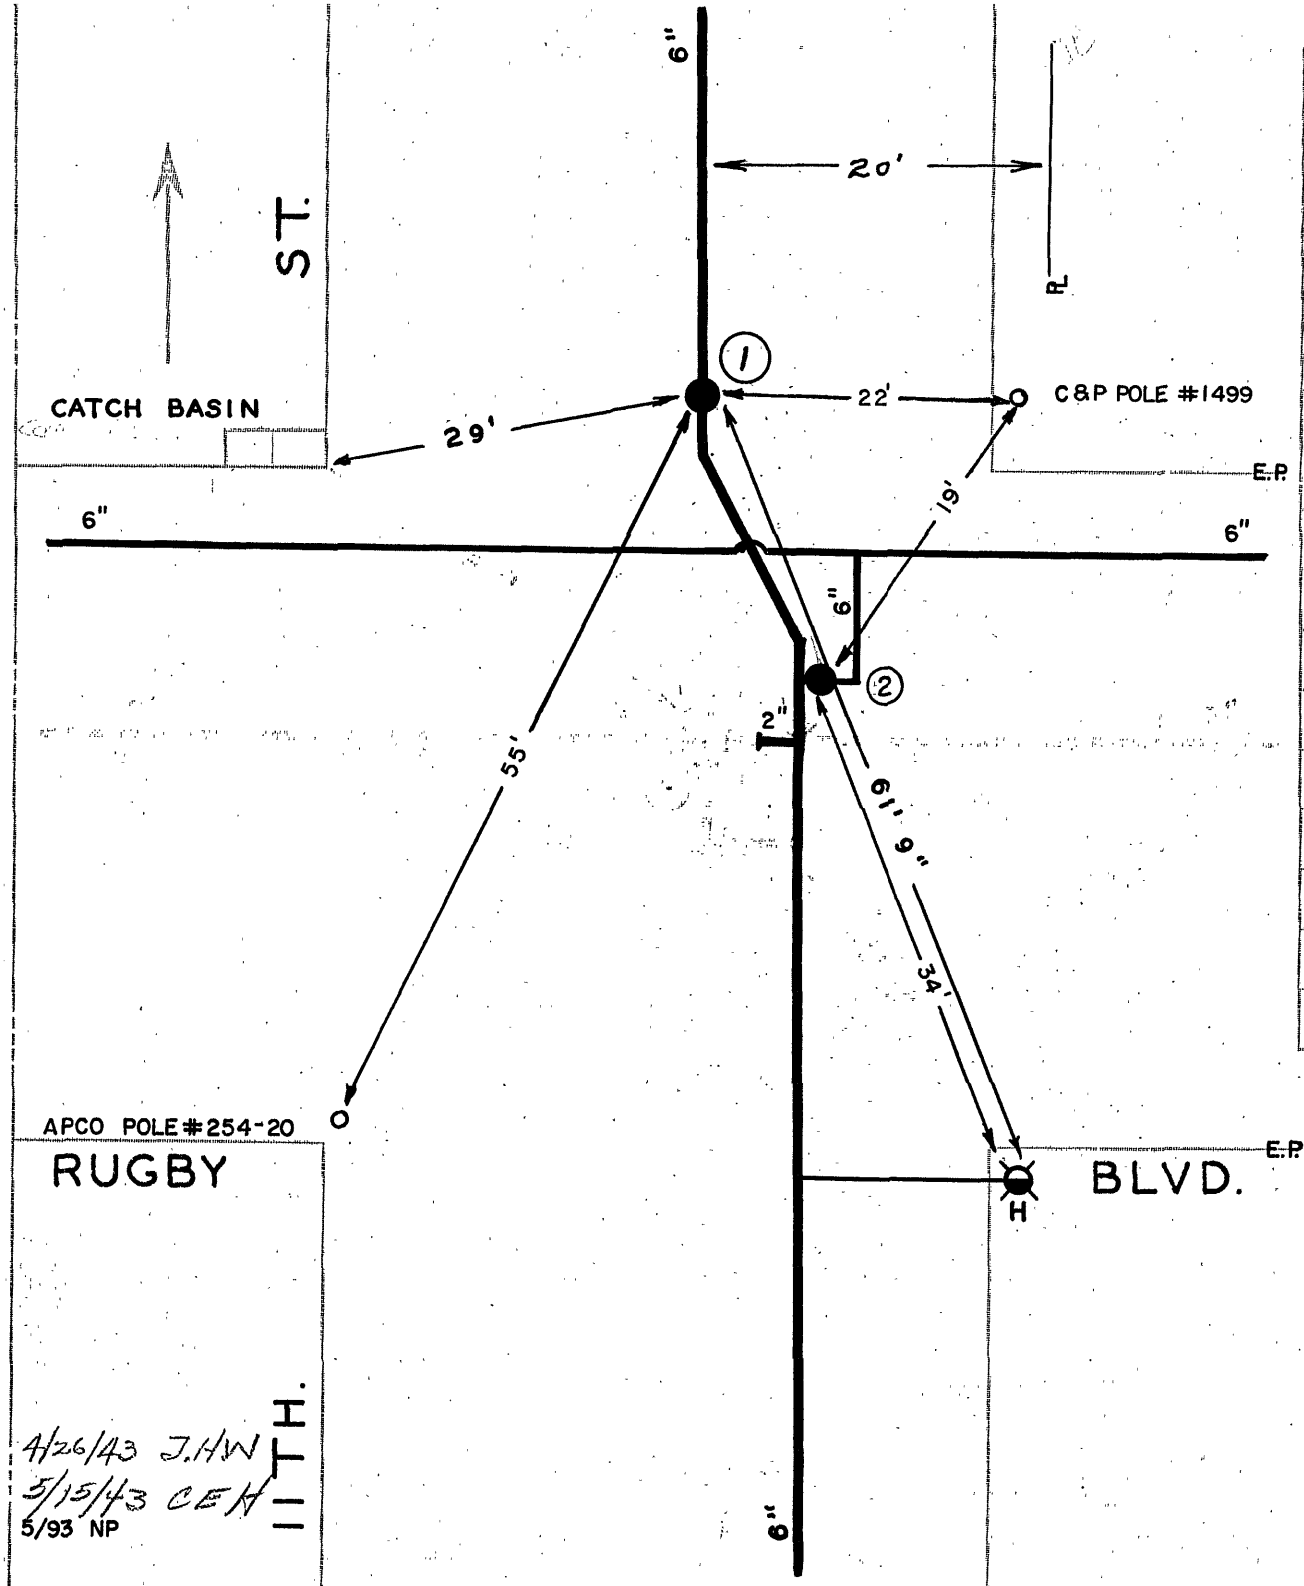


| DATE | NO. | SIZE | MAKE | OPEN | TURNS |
|---|---|---|---|---|---|
| 1939 | 1 | 6" | | R | 20 |
| 9-92 | 2 | 6" | MUELLER | R | 19 |
| | | | | | |
| | | | | | |
| | | | | | |
| | | | | | |
| | | | | | |
| | | | | | |
| | | | | | |
| | | | | | |
| | 1 | 0 | NPL | | |
| | | | | | |
| | | | | | |
| | | | | | |

CITY OF ROANOKE—WATER DEP'T

VALVE DIAGRAM

RUGBY BLVD & 11TH. ST. N. W.

SEC. MAP 223

DATE

PAGE NO. N.W. 170