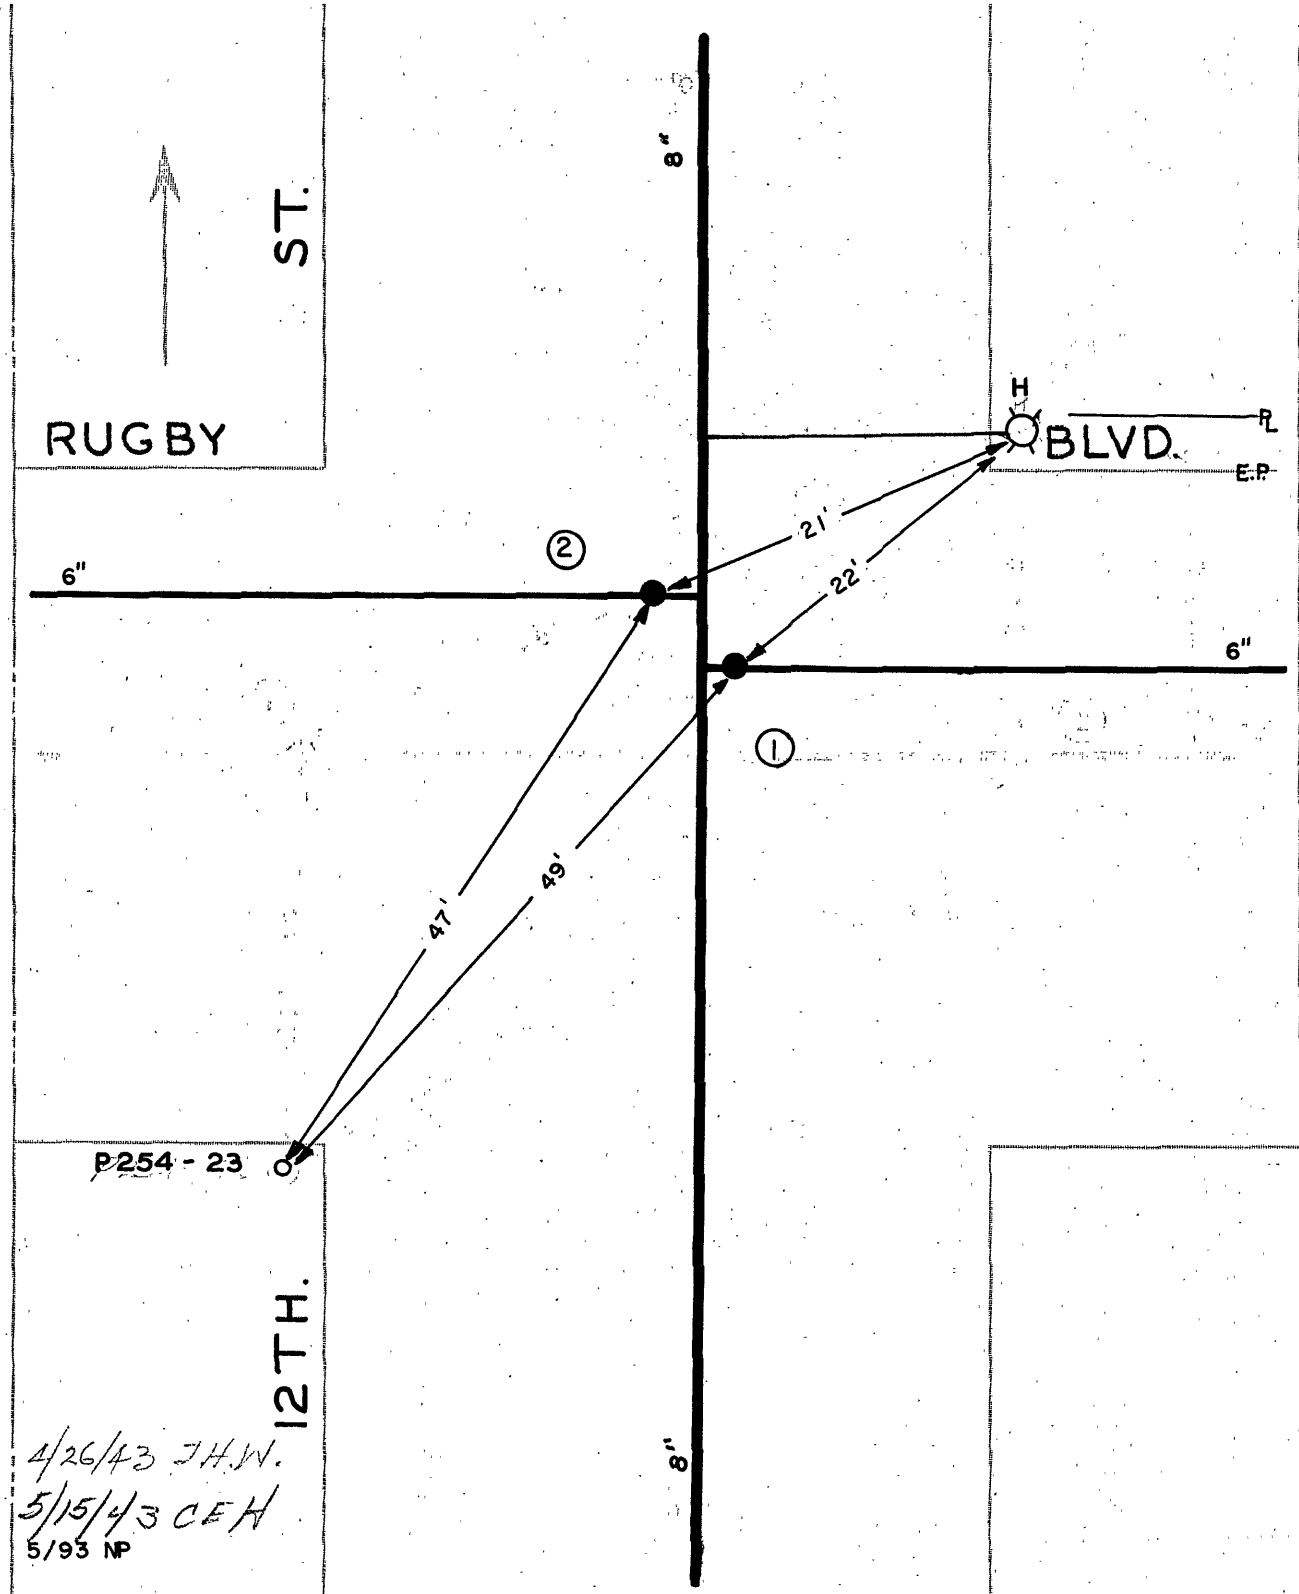

DATE	NO.	SIZE	MAKE	OPEN	TURNS
9-92	1	6"	MUELLER	R	21
9-92	2	6"	MUELLER	R	21

4/26/43 J.H.W.
5/15/43 C.E.H.
5/93 NP

CITY OF ROANOKE—WATER DEP'T

VALVE DIAGRAM

RUGBY BLVD. & 12TH. ST. N. W.

SEC. MAP 223

DATE

PAGE NO. N.W.171