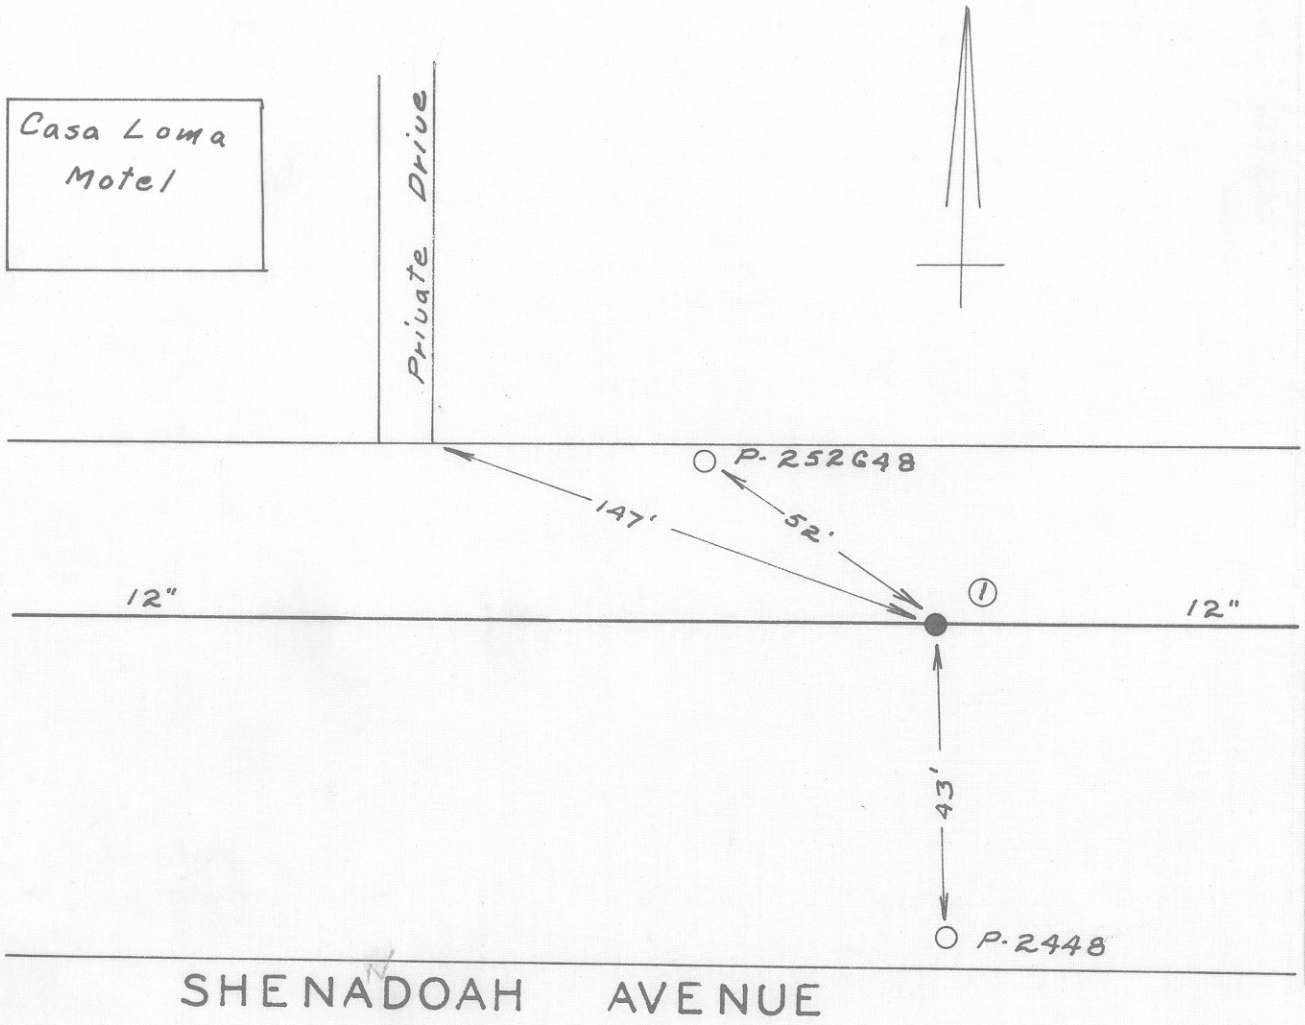

DATE	NO.	SIZE	MAKE	OPEN	TURNS
	1	12"	MUELLER	R	38

CITY OF ROANOKE — WATER DEPT.

VALVE DIAGRAM

SHENADOAH AVE. 147' E. OF CASA LOMA PRIVATE DRIVE

SEC. MAP 28

DATE PAGE NO.

"IMPERIAL" TRACING CLOTH
K & E CO., N. Y.