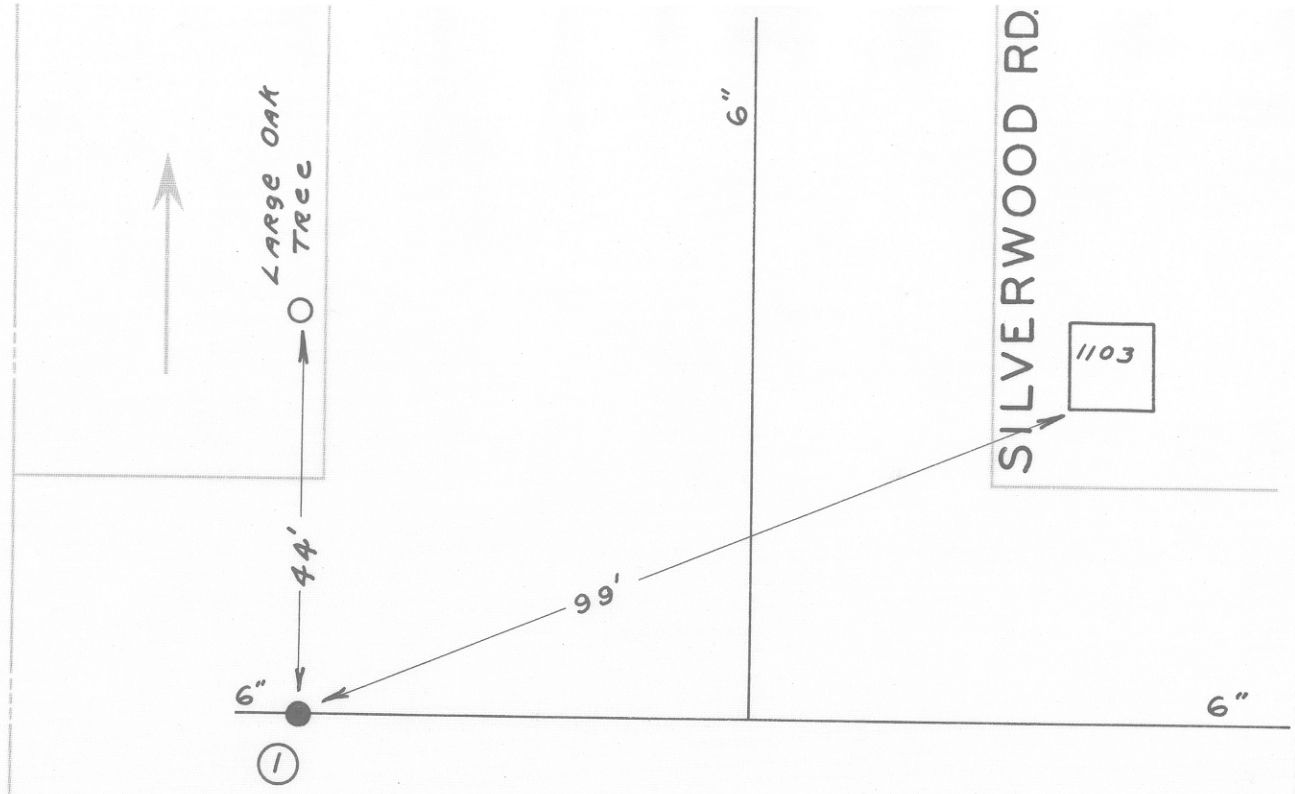

DATE	NO.	SIZE	MAKE	OPEN	TURNS
'56	1	6"	MUELLER	R	
	1	0	WPL		

3/2001 JH

CITY OF ROANOKE—WATER DEP'T
VALVE DIAGRAM
SILVERWOOD RD. &
SUMMITT DRIVE
SEC. MAP 607 N.W.
DATE PAGE NO.