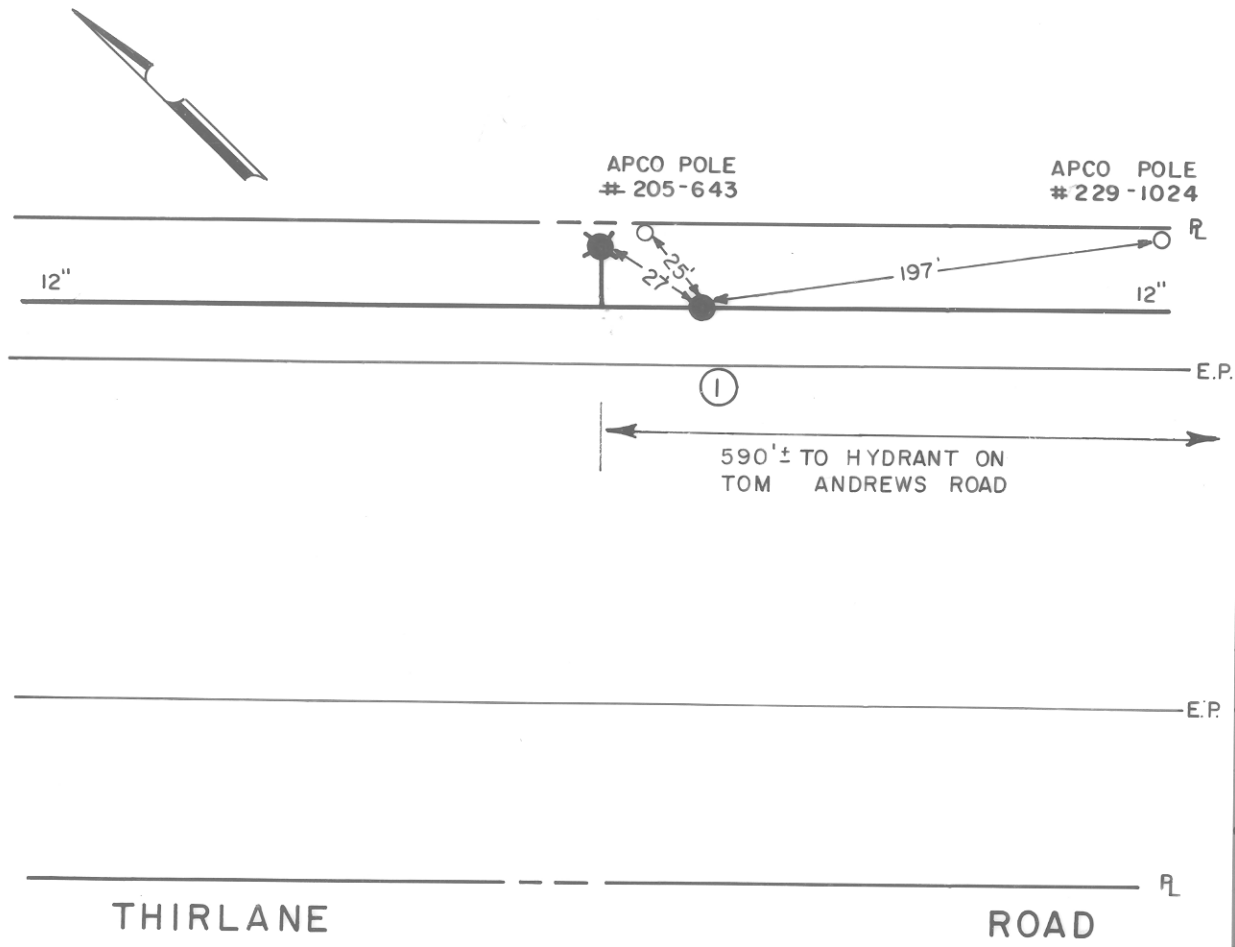

DATE	NO.	SIZE	MAKE	OPEN	TURNS
1991	1	2"	MUELLER	R	

3/92 NP
3/2001 JH

CITY OF ROANOKE - WATER DEP'T.

VALVE DIAGRAM

THIRLANE ROAD

3700 BLOCK

(1000' N. OF COMFORT INN ENTR.)

SEC. MAP 653 N.W.

DATE: PAGE NO.