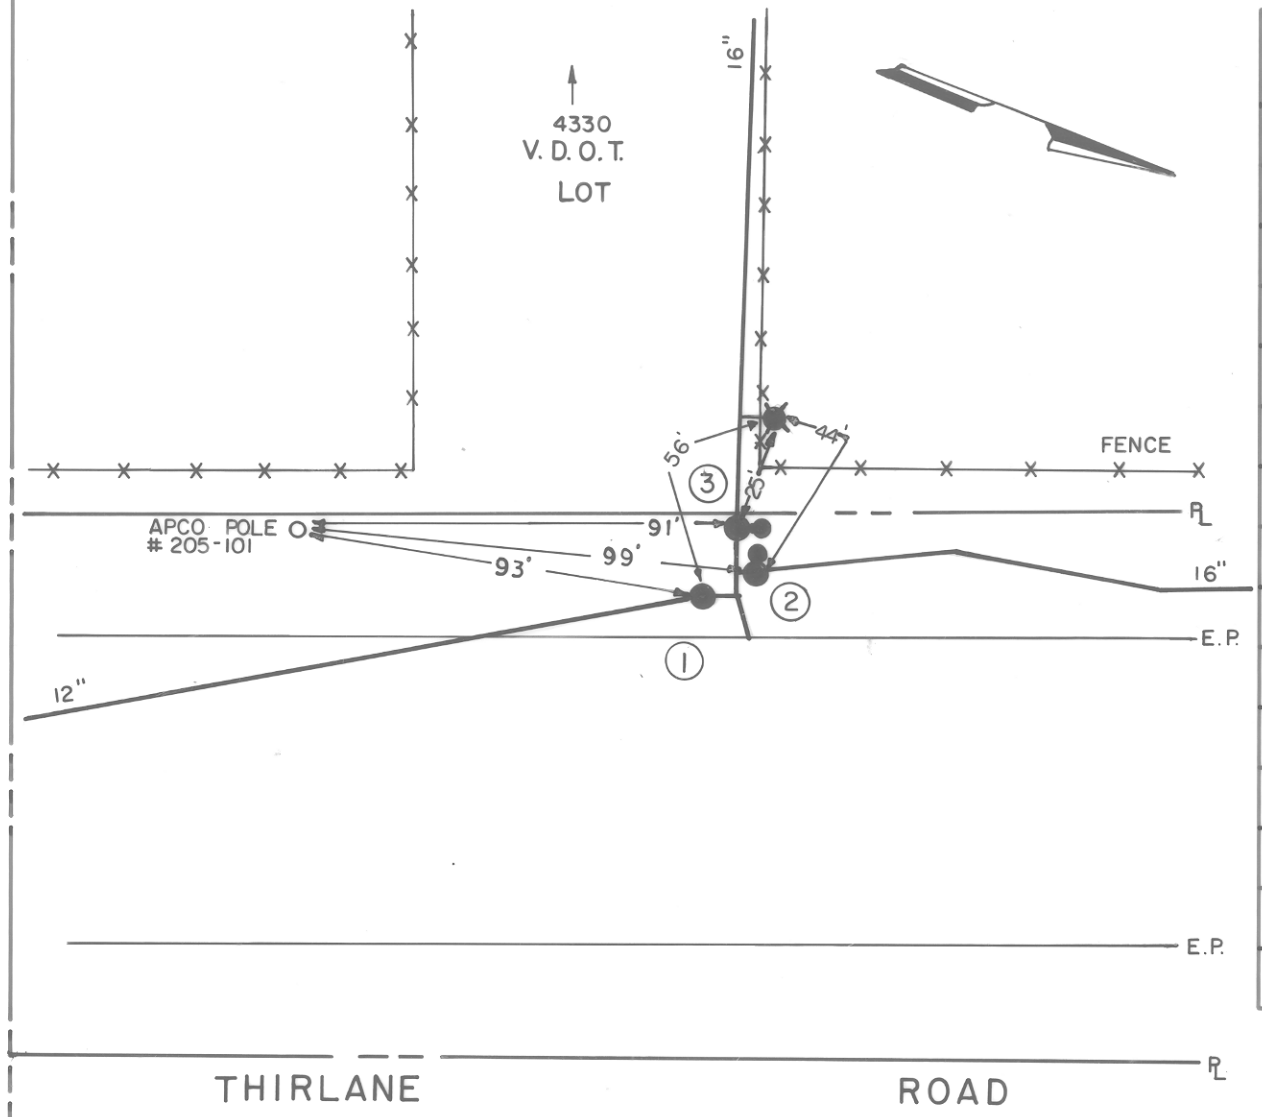

DATE	NO.	SIZE	MAKE	OPEN	TURNS
1987	1	12"	MUELLER	R	
1991	2	16"	MUELLER	R	
1976	3	16"	MUELLER	R	

CITY OF ROANOKE - WATER DEP'T.

VALVE DIAGRAM

THIRLANE ROAD

4300 BLOCK

SEC. MAP 650 N.W.

DATE: PAGE NO.

3/92 NP