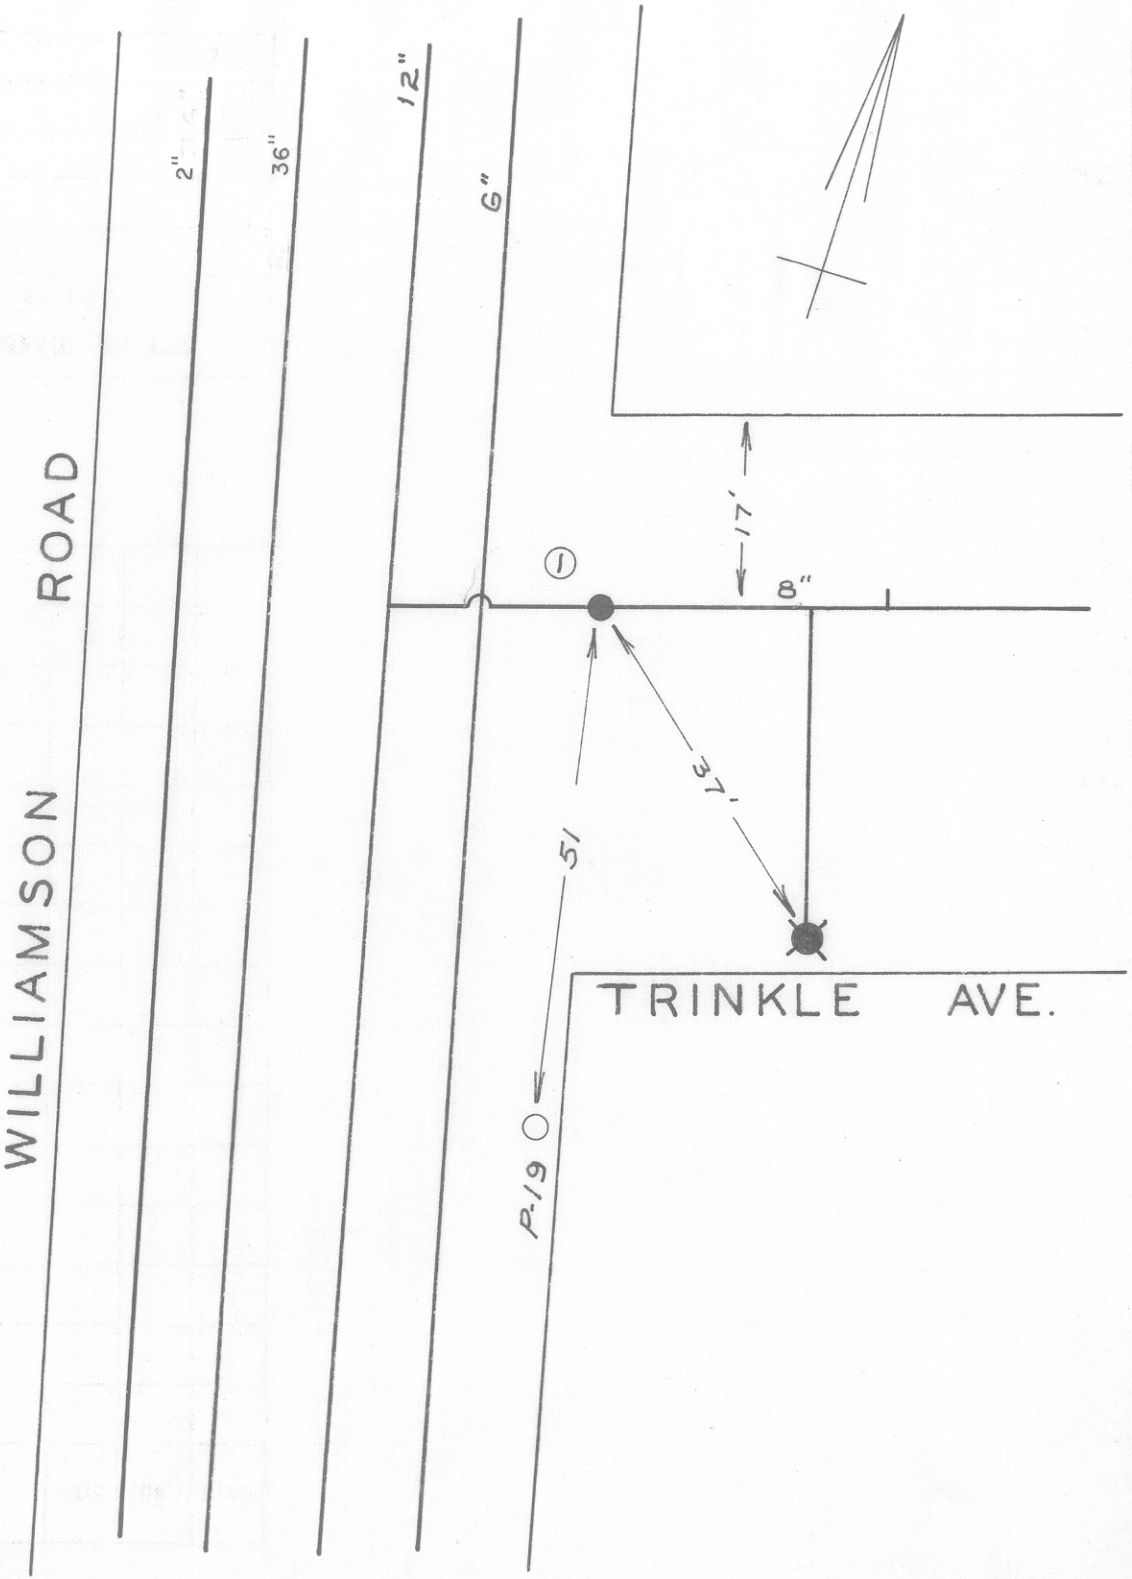

DATE	NO.	SIZE	MAKE	OPEN	TURNS
1952	1	8"	MUELLER	R	27
	1	0	EPL		

3/2001 JH

CITY OF ROANOKE—WATER DEPT.

VALVE DIAGRAM

TRINKLE AVE. &

WILLIAMSON RD. N.W.

SEC. MAP 210, 216 N.W.

DATE PAGE NO.

"IMPERIAL" TRACING CLOTH
K & E CO., N. Y.