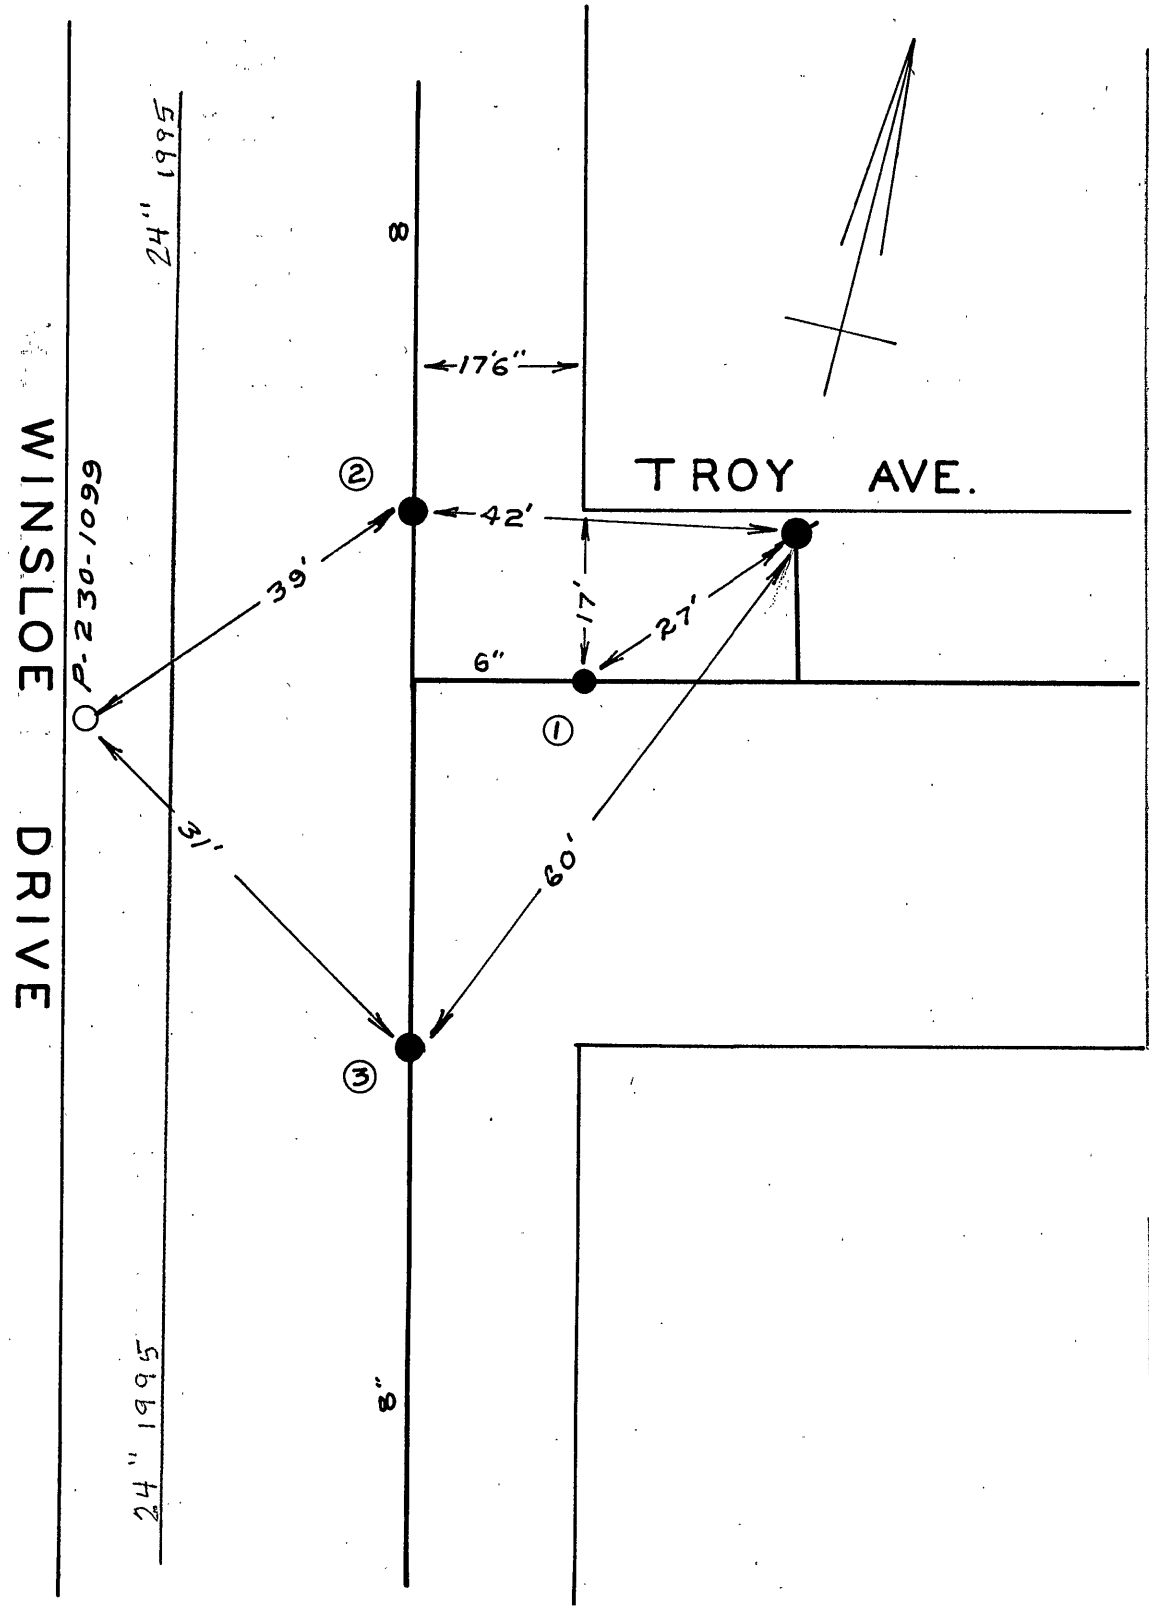

DATE	NO.	SIZE	MAKE	OPEN	TURNS
1955	1	6"	MUELLER	R	21
1956	2	8"	MUELLER	R	
1955	3	8"	MUELLER	R	
	1	0	EPL		
	2	0	NPL		
	3	0	SPL		

CITY OF ROANOKE — WATER DEPT.

VALVE DIAGRAM

TROY AVE. & WINSLOE

WINSLOE DRIVE

SEC. MAP: 209 N.W.

DATE: PAGE NO.

3/2001 JH

"IMPERIAL" TRACING CLOTH
K & E CO., N.Y.