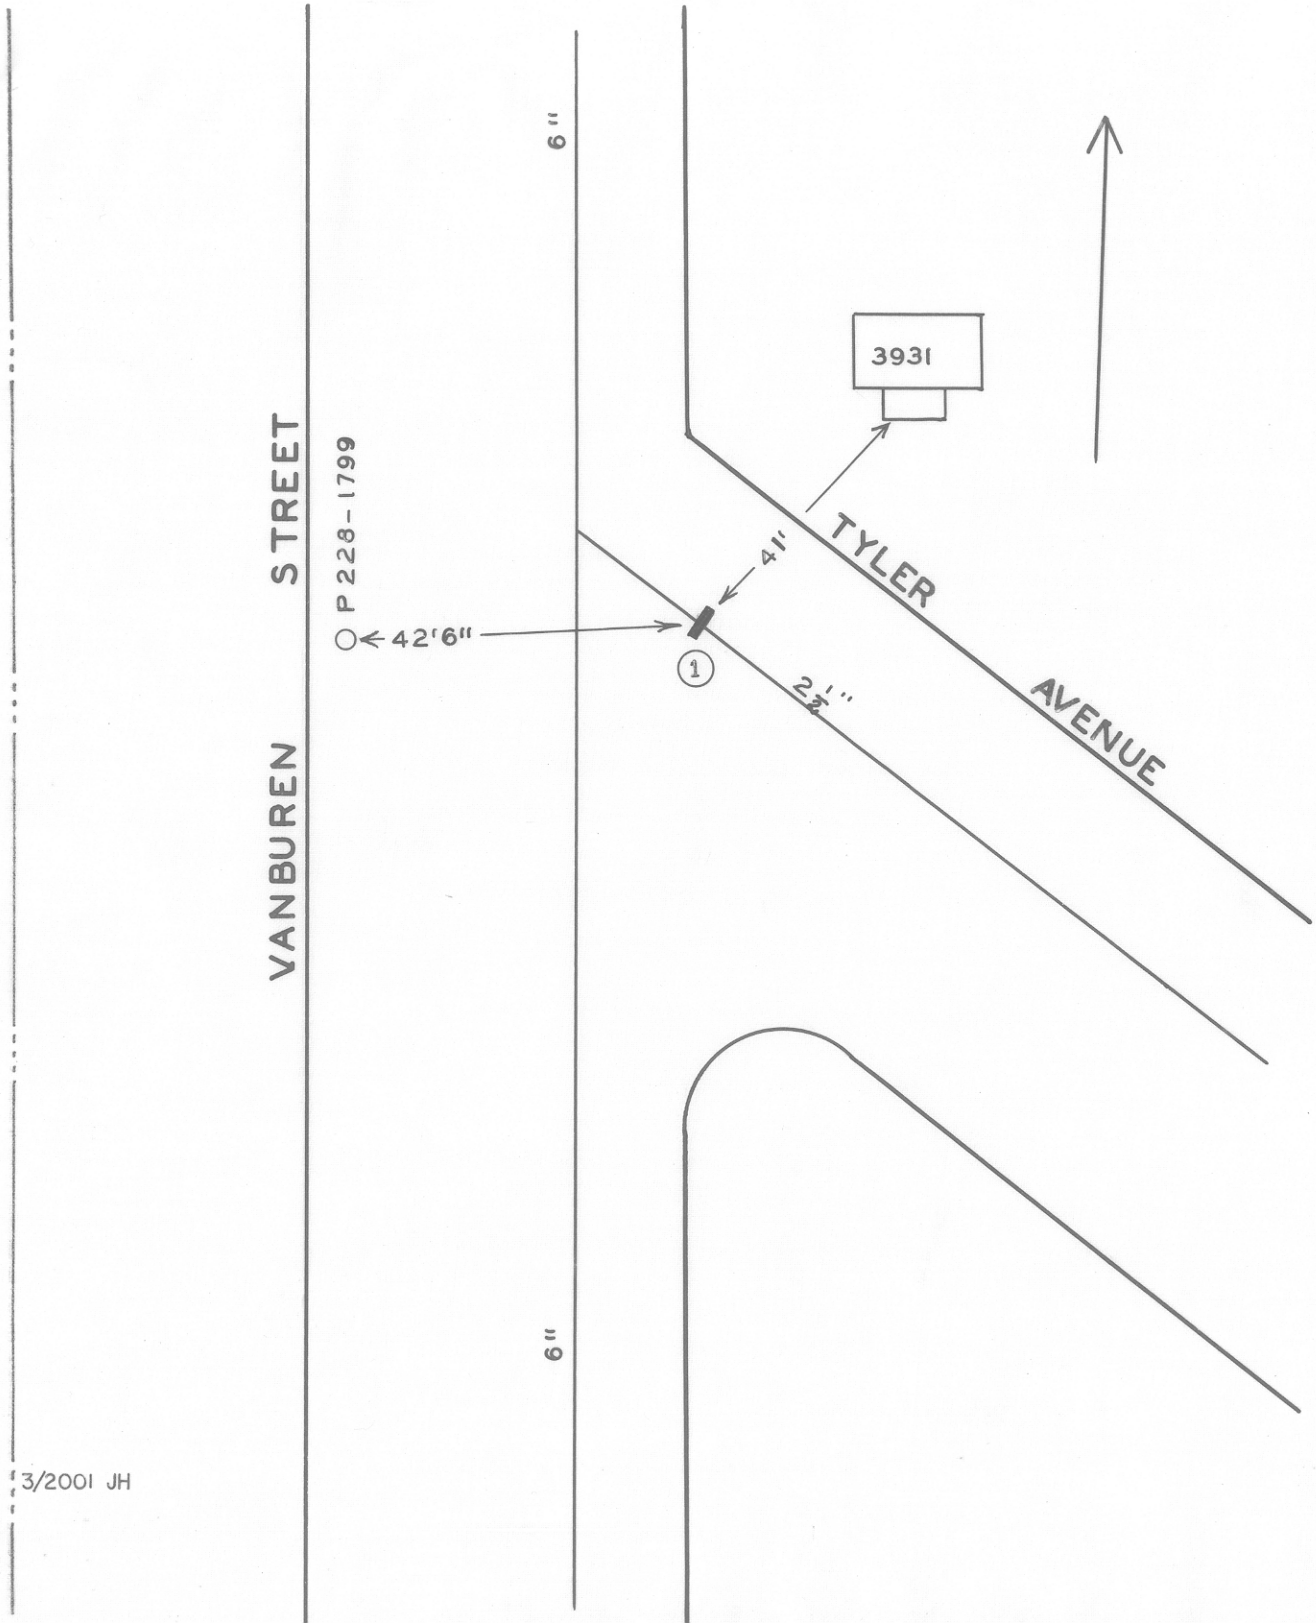

DATE	NO.	SIZE	MAKE	OPEN	TURNS
1-63	1	2"	MISC.	L	

3/2001 JH

CITY OF ROANOKE — WATER DEPT.

VALVE DIAGRAM

TYLER AVENUE &

VAN BUREN STREET N.W.

SEC. MAP 275

DATE PAGE NO.