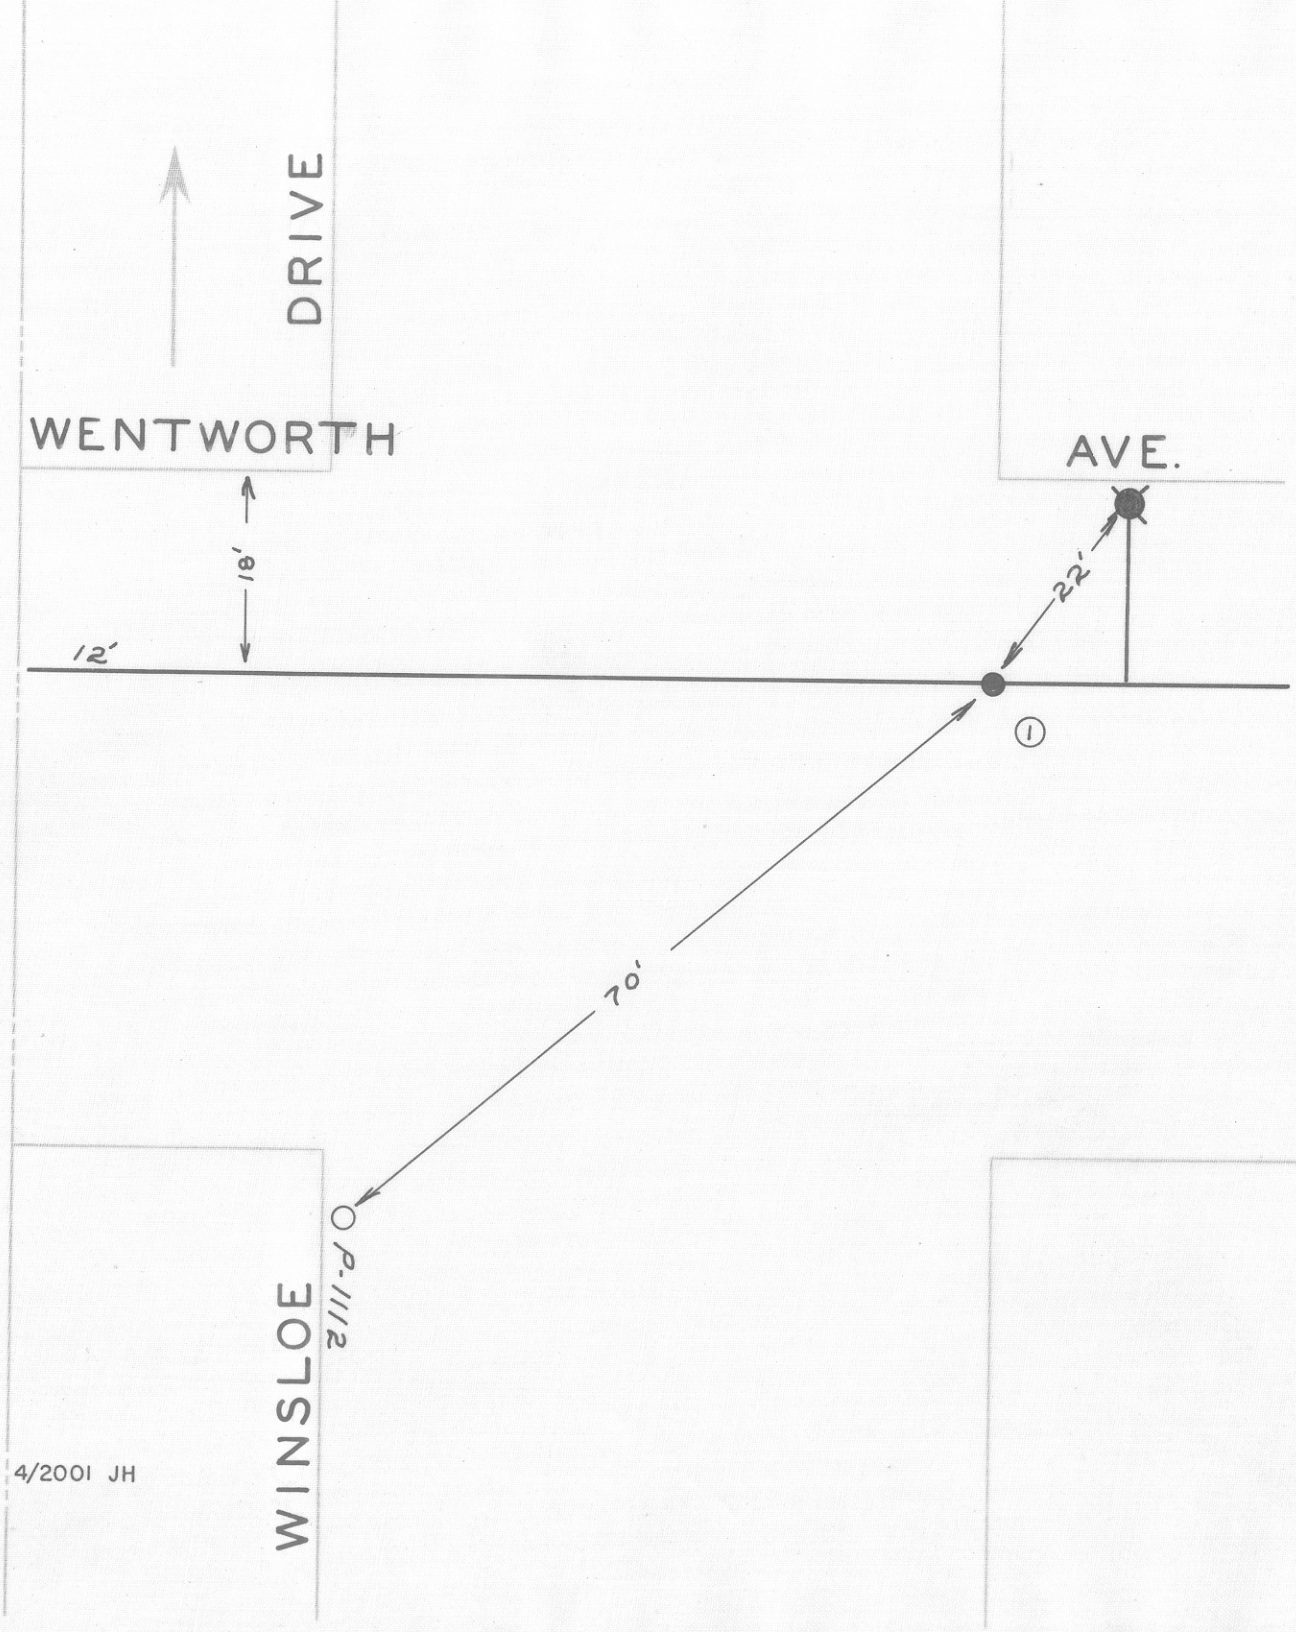

DATE	NO.	SIZE	MAKE	OPEN	TURNS
1953	1	12"			
	1	0	EPL		

4/2001 JH

CITY OF ROANOKE—WATER DEP'T

VALVE DIAGRAM

WENTWORTH AVE. &
WINSLOE DR.

SEC. MAP 209 N.W.

DATE PAGE NO.