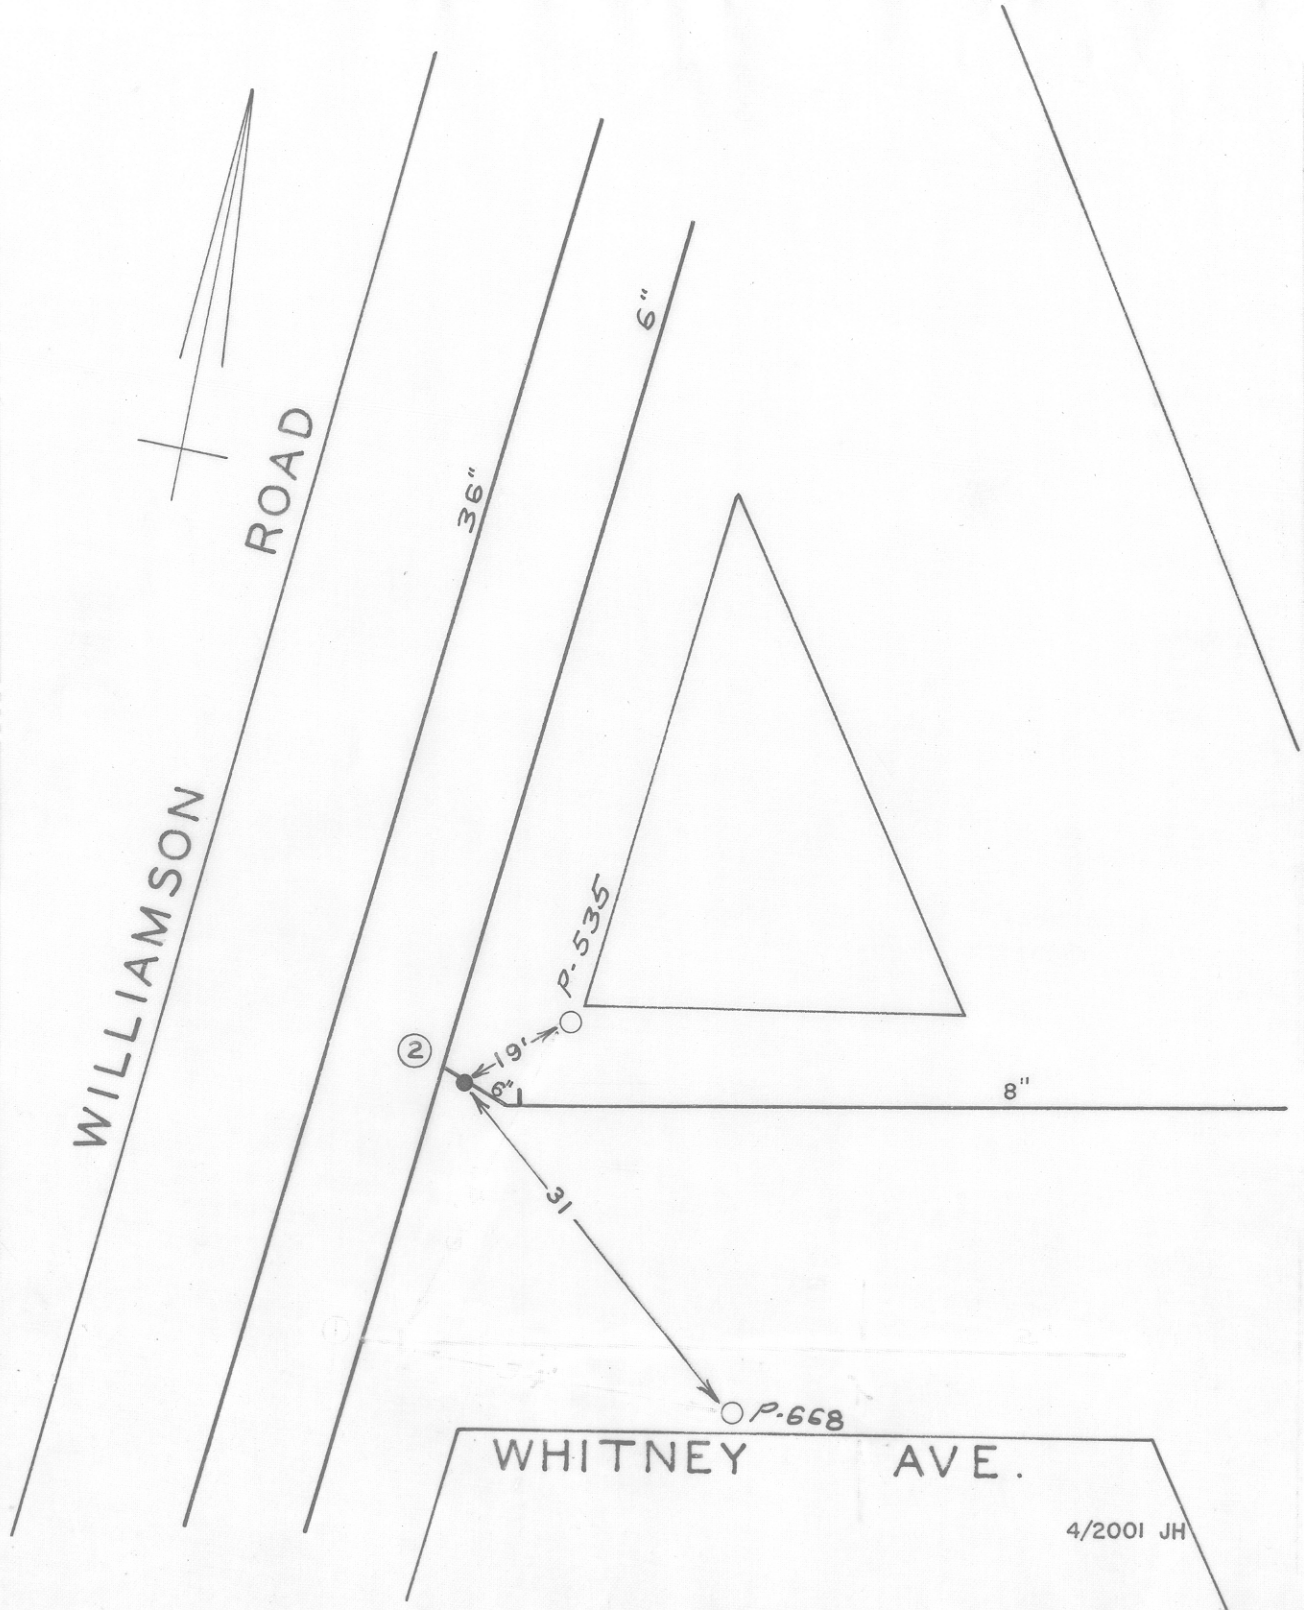

DATE	NO.	SIZE	MAKE	OPEN	TURNS
	~~1~~	~~2"~~			
5-64	2	6"	DARLING	R	
	1	13'-W	E P L		
	2	9W	E.P.L.		

CITY OF ROANOKE — WATER DEPT.

VALVE DIAGRAM

WHITNEY AVE. &

WILLIAMSON RD.

SEC. MAP 219 N.W.

DATE PAGE NO.

"IMPERIAL" TRACING CLOTH.
K & E CO., N. Y.