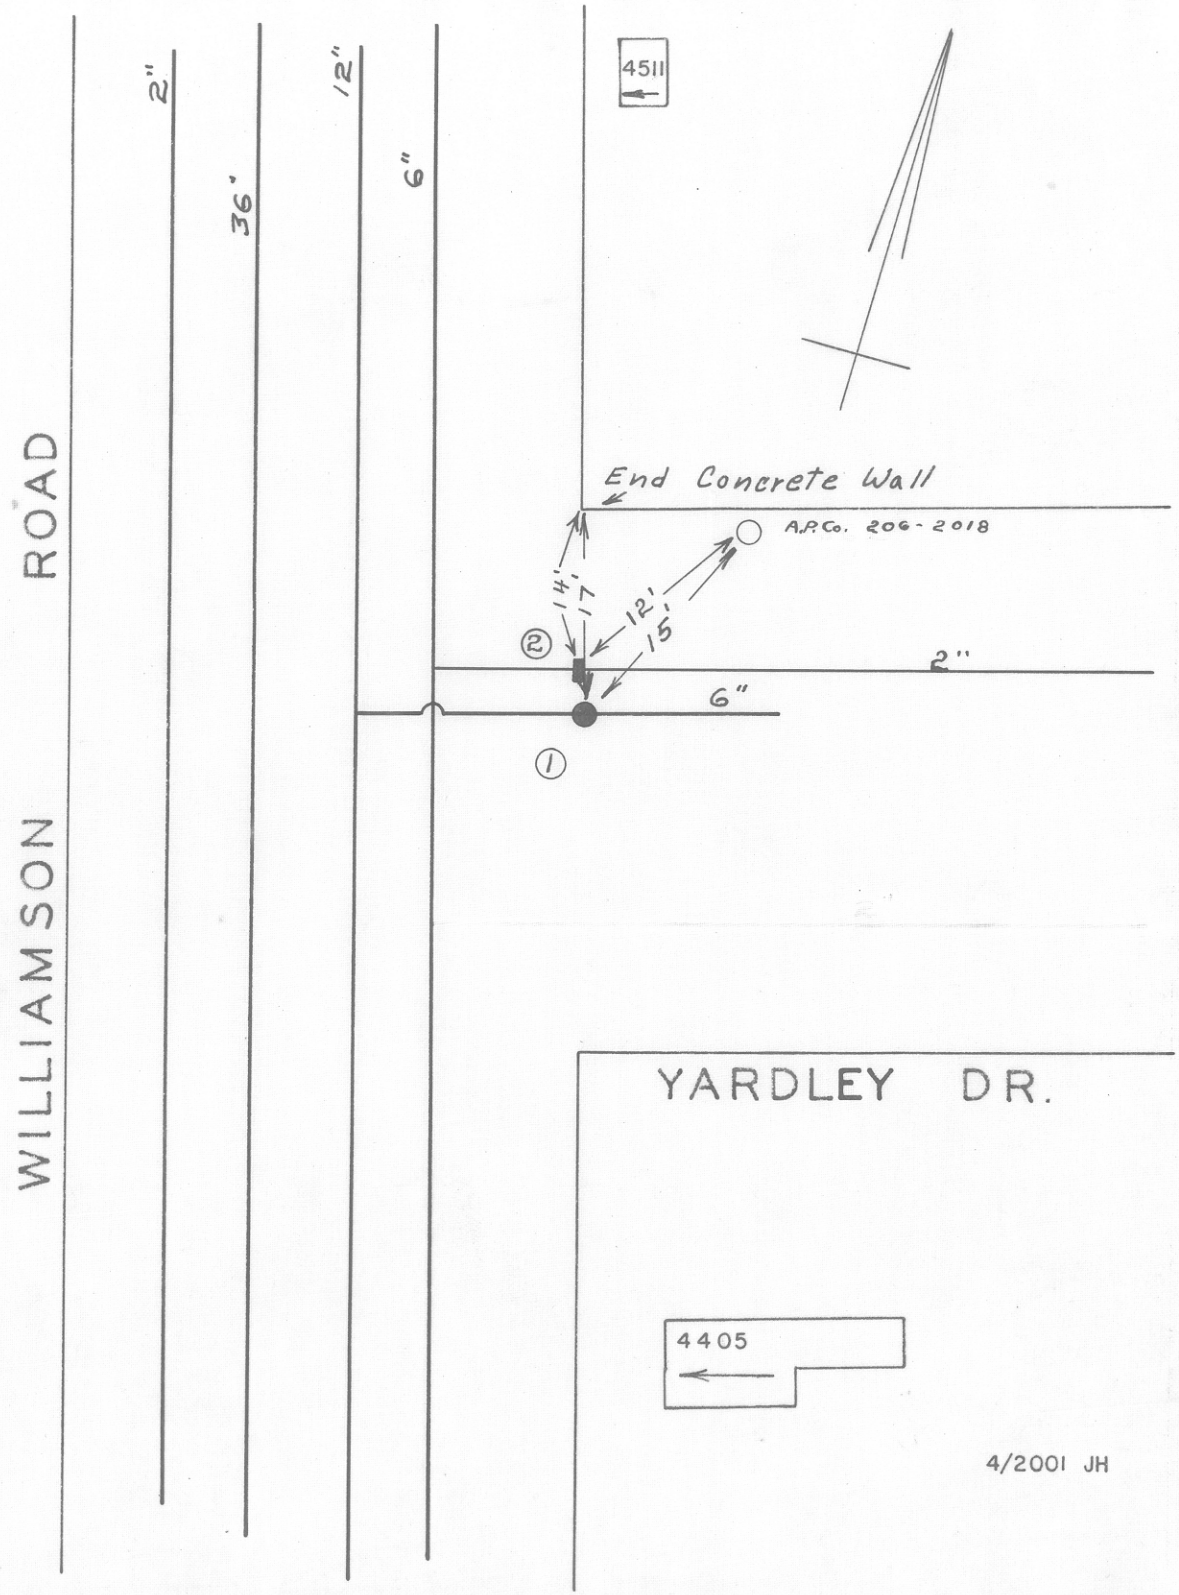

DATE	NO.	SIZE	MAKE	OPEN	TURNS
1952	1	6"			
6-60	2	2"	DARLING	R	
	1	0	EPL		
	2	0	E.P.L.		

CITY OF ROANOKE — WATER DEPT.

VALVE DIAGRAM

WILLIAMSON RD. &

YARDLEY DRIVE N. W.

SEC. MAP 217 228 N.W.

DATE PAGE NO.