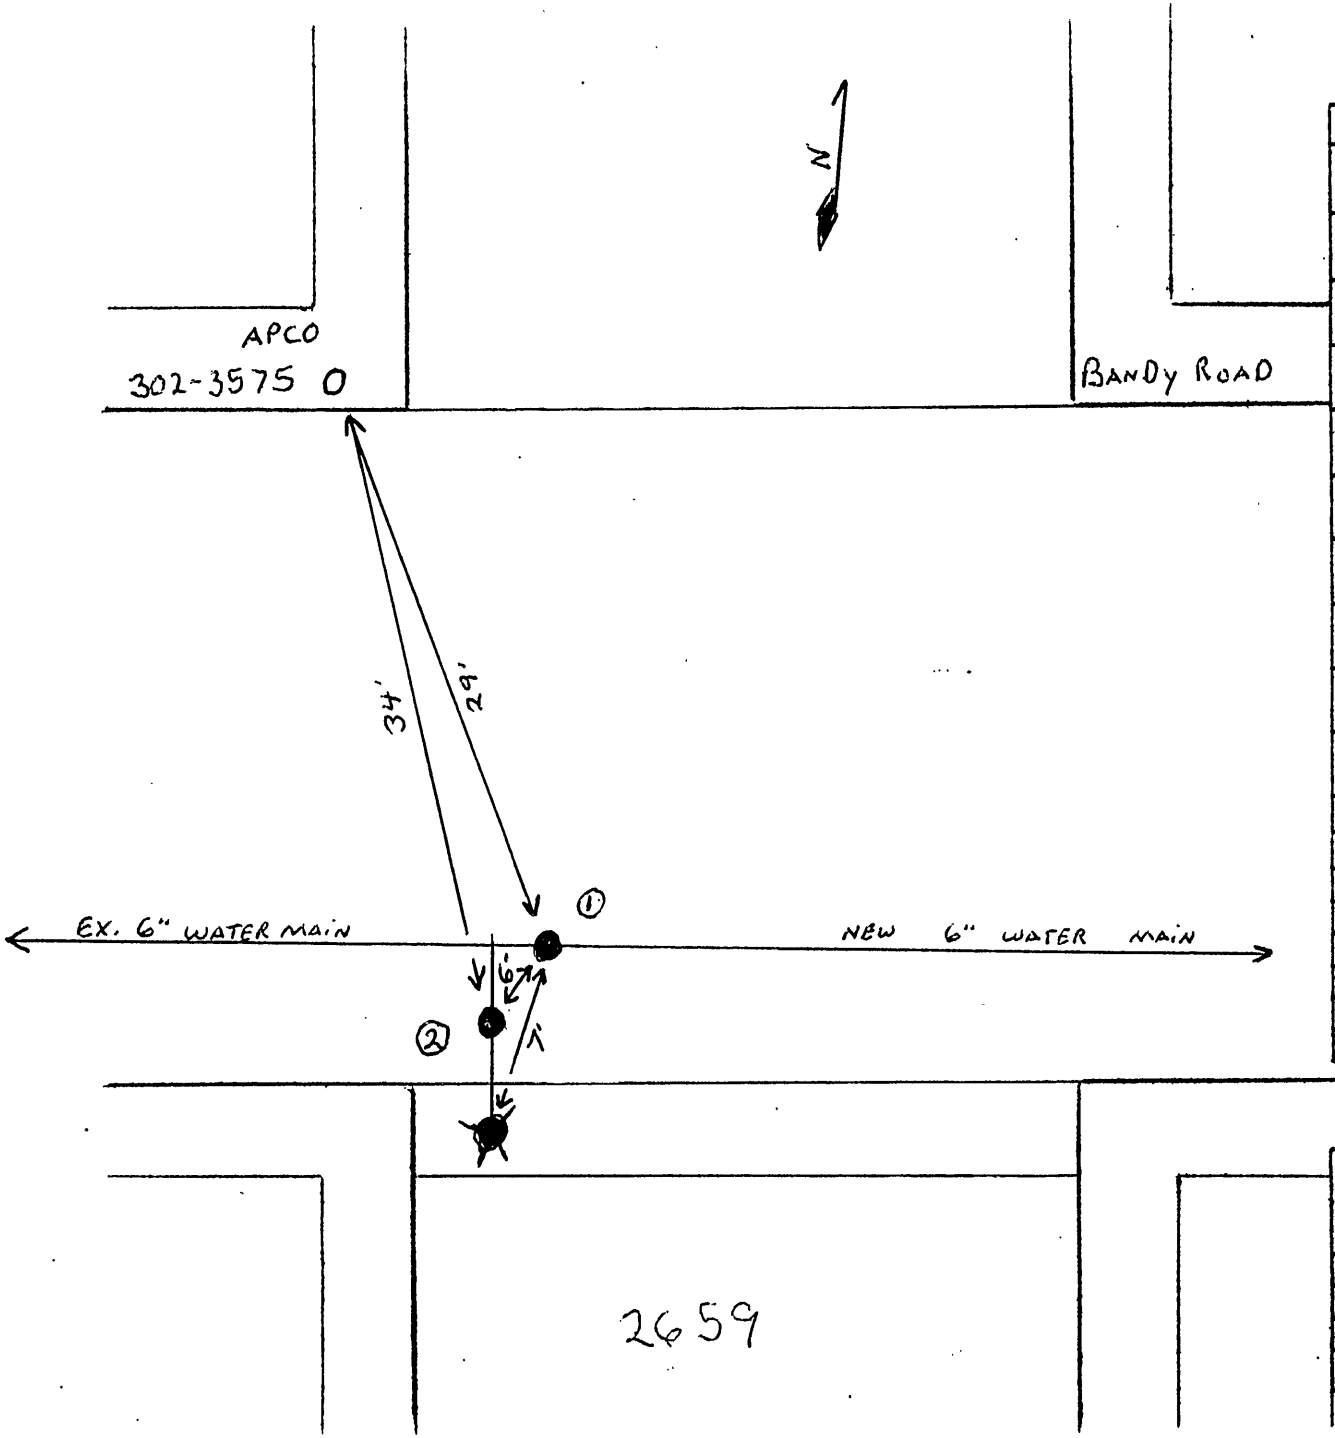

DATE	NO.	SIZE	MAKE	OPEN	TURNS
12-10-98	1	6"	DARLING	R	21
81	2	6"	MULL	R	21

P. L. Measurements		
No.	Distance	Direction

CITY OF ROANOKE - WATER DEPT.

VALVE DIAGRAM

2600 Block of Bandy Road SE.

Sec. Map 426

Date 12-10-98 Page No.