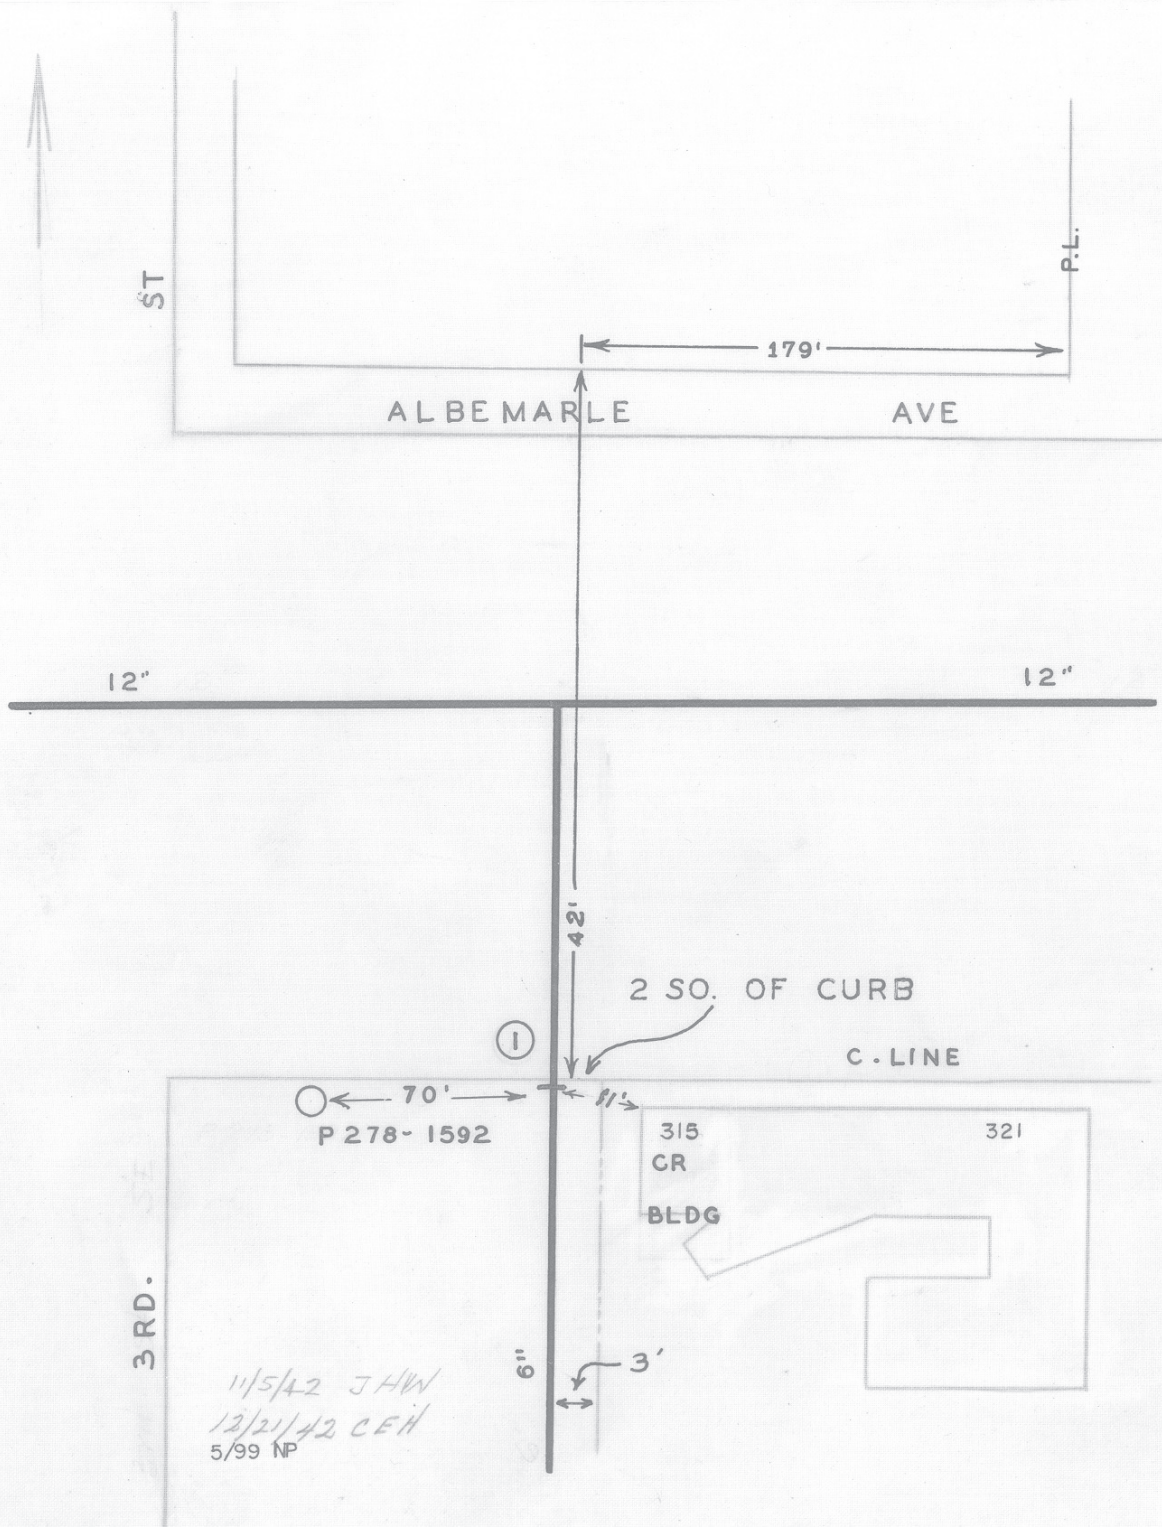

DATE	NO.	SIZE	MAKE	OPEN	TURNS
1915	1	6"		R	21
	1	7'-N	SPL		

CITY OF ROANOKE—WATER DEP'T

VALVE DIAGRAM

VALVE ON 6" MAIN SOUTH FROM ALBEMARLE E. OF 3RD. ST.-300 BLK. ALBEMARLE

SEC. MAP 402 S.E.

DATE PAGE NO. S.E.50