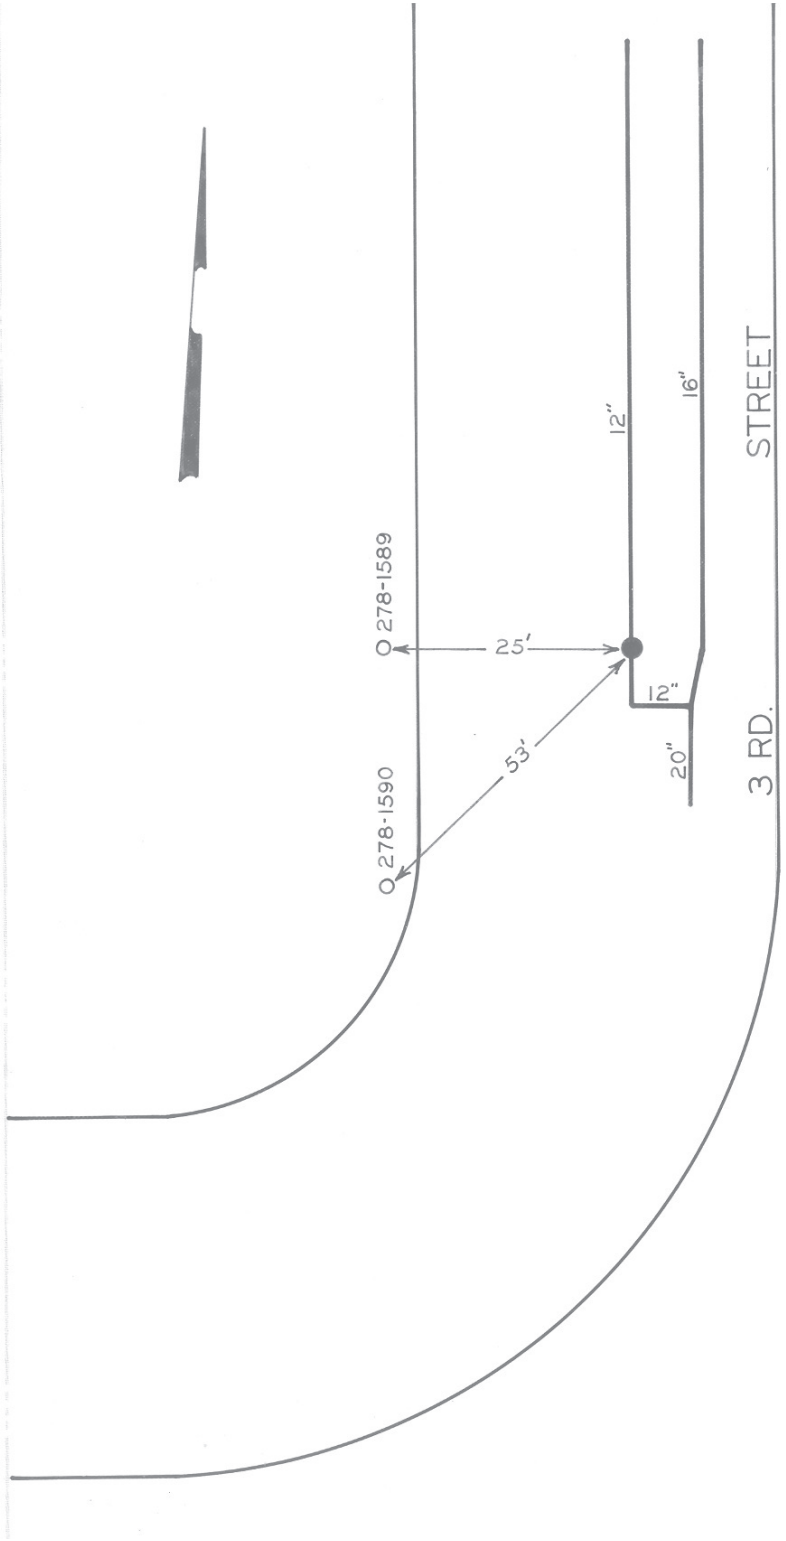


| DATE | NO. | SIZE | MAKE | OPEN | TURNS |
|---|---|---|---|---|---|
| 6-72 | 1 | 12" | MUELLER | R | |

CITY OF ROANOKE—WATER DEP'T

VALVE DIAGRAM

3 RD. STREET S.E. – 400'± NORTH OF WALNUT AVENUE BRIDGE

SEC. MAP 403

DATE PAGE NO.