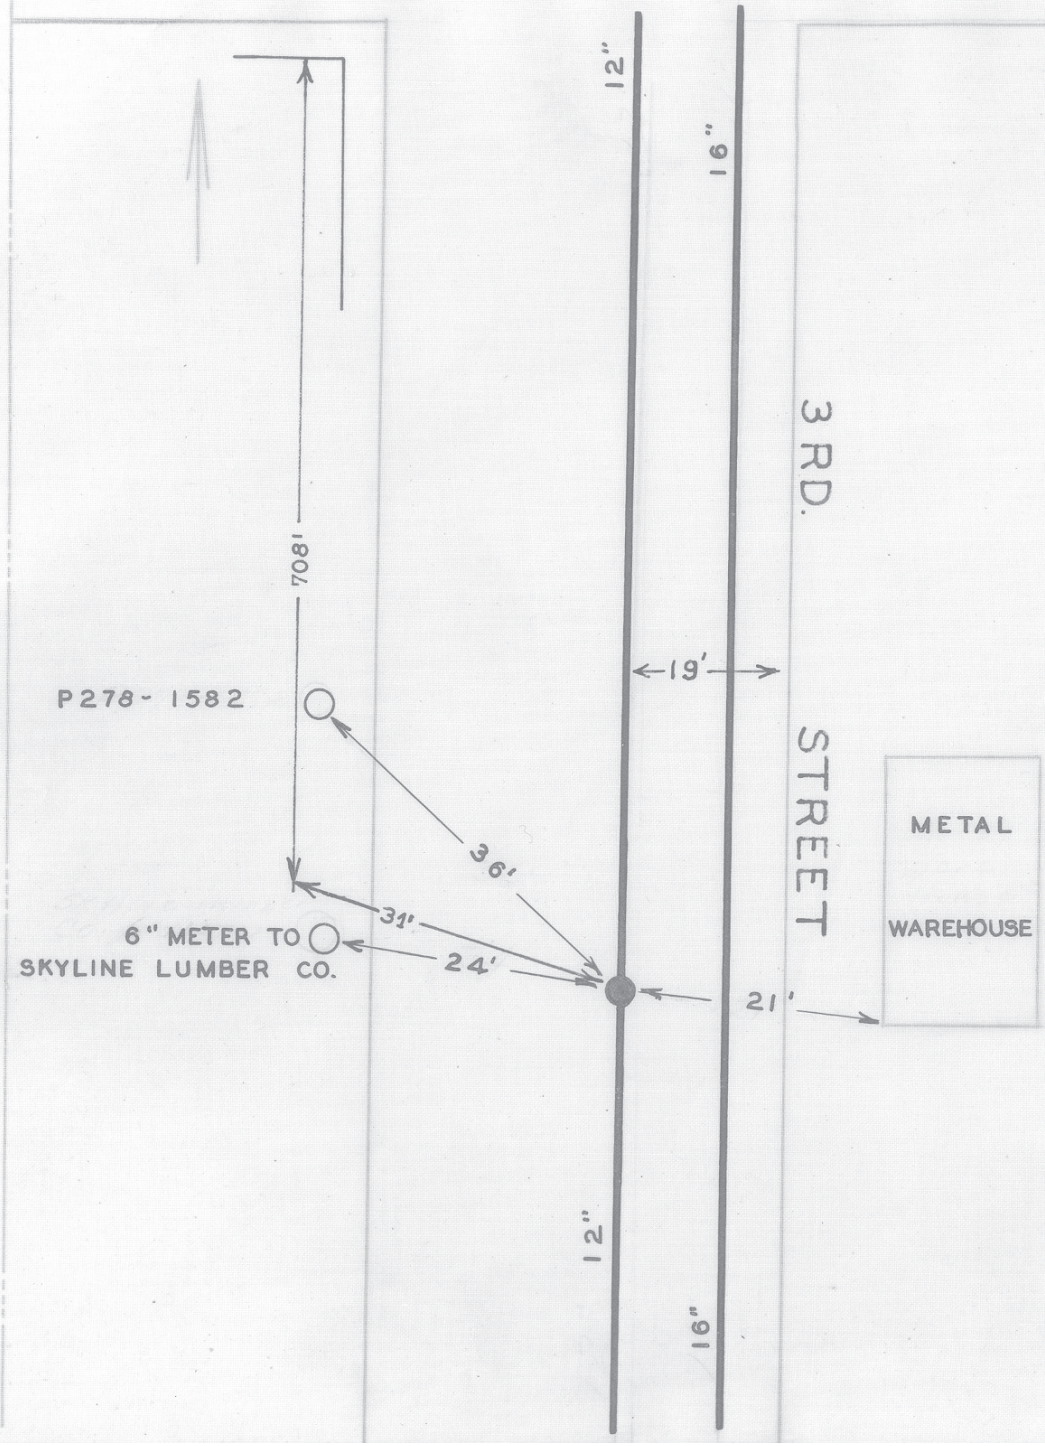

DATE	NO.	SIZE	MAKE	OPEN	TURNS
1923	1	12"		R	37 1/2

CITY OF ROANOKE—WATER DEP'T

VALVE DIAGRAM

3RD. ST. S.E. APPROX. 700'

S. OF ALBEMARLE AVE.

S.E.

SEC. MAP 402

DATE

PAGE NO S.E.52