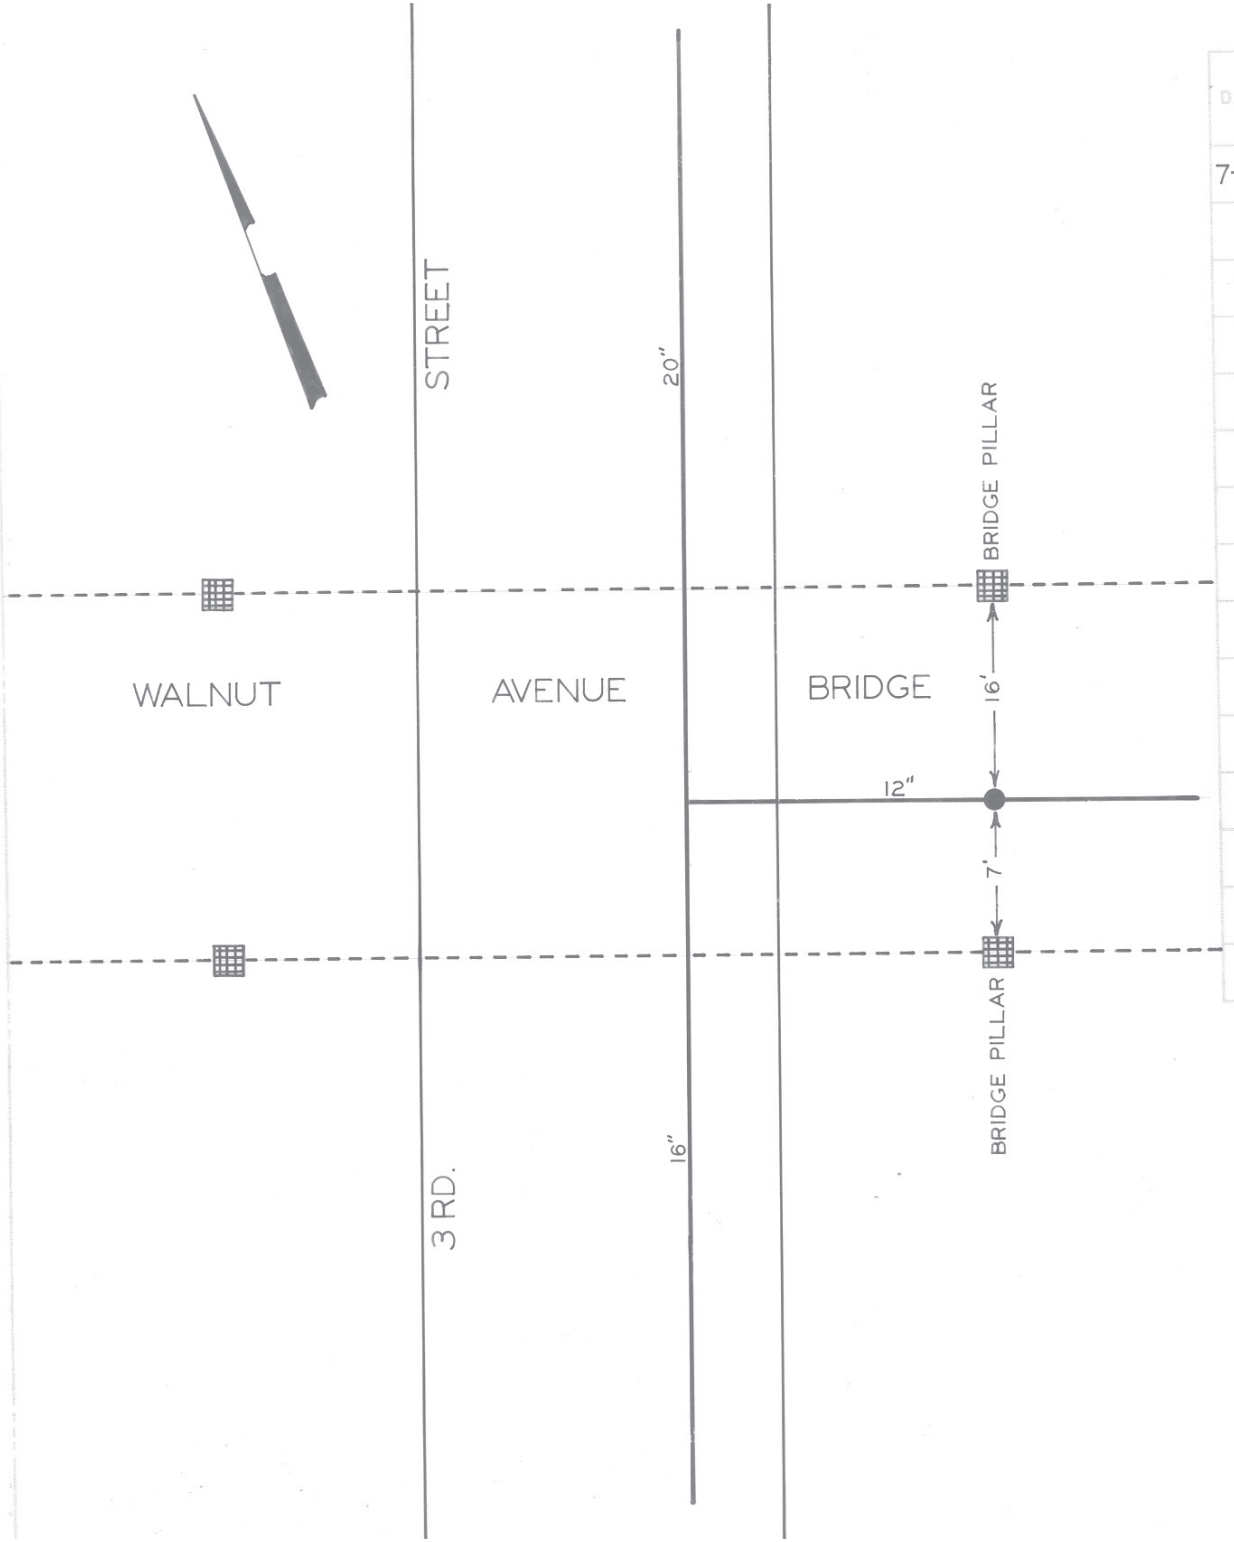

DATE	NO.	SIZE	MAKE	OPEN	TURNS
7-72	1	12"	MUELLER	R	

CITY OF ROANOKE—WATER DEP'T

VALVE DIAGRAM

3 RD. STREET S.E. UNDER
WALNUT AVENUE BRIDGE

SEC. MAP 403

DATE PAGE NO.