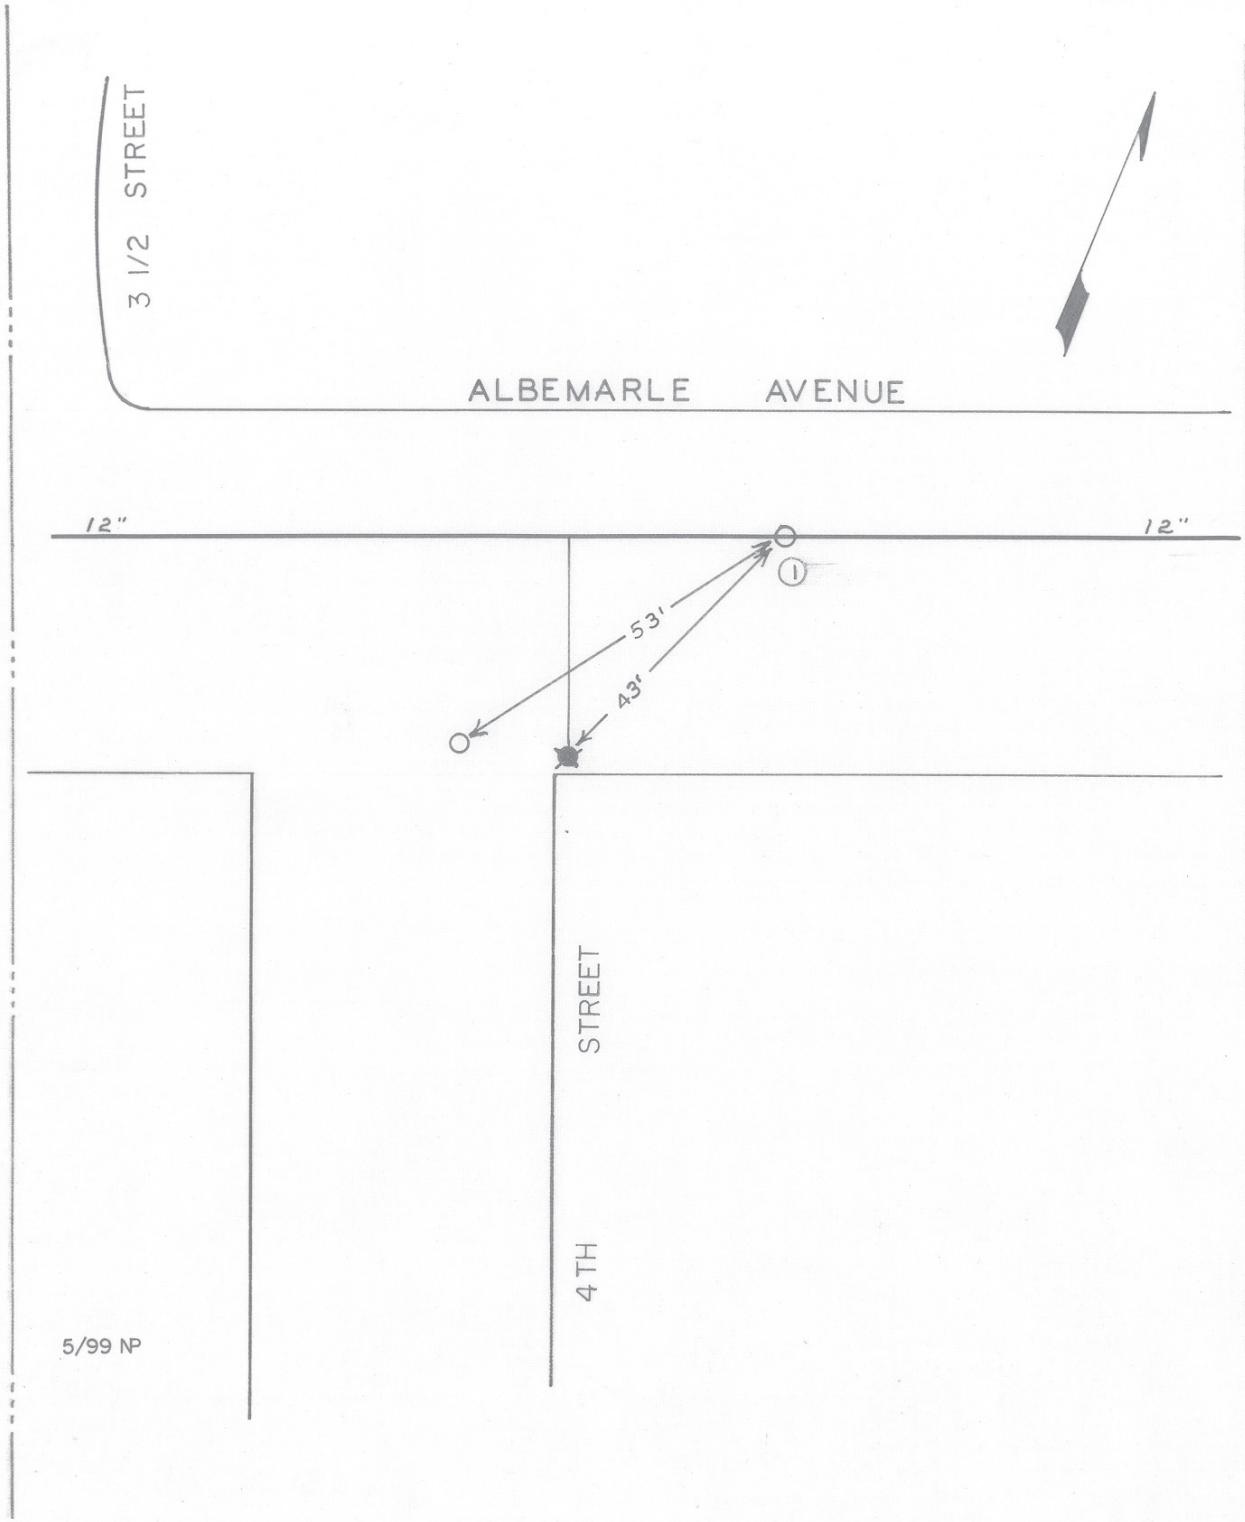

DATE	NO.	SIZE	MAKE	OPEN	TURNS
4-67	1	1"	PITOT STA.		

CITY OF ROANOKE—WATER DEPT.

VALVE DIAGRAM

ALBEMARLE AVENUE 100'±

EAST OF 3½TH STREET

SEC. MAP 402 S.E.

DATE PAGE NO.